

PARE PROJECT NO. 08216.00

**INSPECTION REPORT  
STEAMSHIP PIER  
NEW BEDFORD WATERFRONT  
FACILITIES INSPECTIONS  
NEW BEDFORD, MASSACHUSETTS**



MARCH 2009

## EXECUTIVE SUMMARY

Steamship Pier is comprised of three principal components: a timber boardwalk, the original pier structure, and the pier extension. The pier currently provides berthage for commercial fishing vessels.

Pare Corporation of Foxboro, Massachusetts, conducted the topside inspection of the site on November 14, 2008. The underwater inspection was conducted on November 14, 2008 by Childs Engineering Corporation of Medfield, Massachusetts. In general, Steamship Pier was found to be in **Fair to Good** condition. Concerns and deficiencies at the site include deteriorated concrete pile jackets, loss of exposed timber pile section, missing and loose pile cross bracing, deteriorated concrete deck, corroded low water connection hardware, and damage to the fender piles, wale, and chocks.

High priority repairs include the encasement of deteriorated piles, reconnection of cross bracing, replacement of broken or excessively damaged fender components, and patching of the concrete deck. The opinion of probable cost for this work is in the order of \$579,600.

Lower priority repairs include the addition of a cathodic protection system, which will increase the remaining useful life of the facility. The opinion of probable cost for this work is in the order of \$105,360.

It is recommended that the facility be inspected at 3 to 5 year intervals to monitor deterioration of the facility components.



## TABLE OF CONTENTS

	<u>Page</u>
<b>SECTION 1 INTRODUCTION</b>	
1.1 Background and Objectives	1
1.2 Scope of Work	1
<b>SECTION 2 DESCRIPTION OF SITE</b>	
2.1 Site Location	1
2.2 Facility Description	1
<b>SECTION 3 EXISTING CONDITIONS</b>	
3.1 General	2
3.2 Original Structure	2
3.2.1 Original Pier - Topside	3
3.2.2 Original Pier - Underwater	3
3.3 Pier Extension	3
3.3.1 Pier Extension - Topside	4
3.3.2 Pier Extension - Underwater	4
3.4 Timber Boardwalk	5
3.4.1 Boardwalk - Topside	5
3.4.2 Boardwalk - Underwater	5
3.5 Fender System and Appurtenances	6
<b>SECTION 4 STRUCTURAL CONDITION ASSESSMENT</b>	
4.1 General	8
4.2 Original Pier	8
4.3 Pier Extension	9
4.4 Timber Boardwalk	9
<b>SECTION 5 RECOMMENDATIONS AND OPINION OF PROBABLE COST</b>	
5.1 Recommendations – General	8
5.2 High Priority	9
5.3 Lower Priority	9

### TABLES:

- Table 3.1 – Fender Deficiencies
- Table 3.2 – Steel Pipe Pile Underwater Readings
- Table 3.3 – Steel Sheet Pile Underwater Readings
- Table 3.4 – Structural Pile Section Loss

### FIGURES:

- Figure 1 – Locus Plan
- Figure 2 – Existing Site Plan – Original Pier
- Figure 3 – Existing Pile Plan – Pier Extension



APPENDICES:

- Appendix A: Photographs
- Appendix B: Key Personnel
- Appendix C: Backup Data for Cost Estimates
- Appendix D: References
- Appendix E: Field Notes





## **SECTION 1 INTRODUCTION**

### *1.1 – Background and Objectives*

The New Bedford Harbor Development Commission (HDC) has retained Pare Corporation (PARE) and Childs Engineering Corporation (CEC) to perform an above and below water inspection, and to develop a report of existing conditions for the Steamship Pier in New Bedford, Massachusetts. Inspections were performed in accordance with the ASCE Manuals and Reports on Engineering Practice No. 101 – Underwater investigations: Standard Practice Manual. The major objectives of the inspection report are to provide the HDC with an assessment of existing conditions at the facility, and to substantiate requests for funding for the maintenance and repair of the facility.

### *1.2 – Scope of Work*

The scope of this investigation is to provide an inspection and evaluation of the present condition of the pier and appurtenant structures, and to provide information that will assist in both prioritizing repair needs and planning/conducting maintenance and operation.

The investigation is divided into three parts: 1) provide a description of the facility, including review of available reports, investigations, and data previously submitted to the owner pertaining to the wharf and appurtenant structures; 2) perform a visual inspection of the site above and below water; 3) prepare and submit a final report presenting the evaluation of the structure, including recommendations for remedial actions, and associated costs.

## **SECTION 2 DESCRIPTION OF SITE**

### *2.1 - Site Location*

Steamship Pier is an approximate 675 foot long pier located within Bristol County in the City of New Bedford, Massachusetts. It is bordered by State Pier to its north and Coal Pocket Pier to the south. Steamship Pier is approximately 1.5 miles south of Route 195 along the New Bedford waterfront on Buzzard's Bay, south of State Pier and north of Coal Pocket Pier as shown in Figure 1 – Locus Plan.

### *2.2 - Facility Description*

Steamship Pier was originally constructed in 1838. Currently listed on the National Register of Historic Places, it was formerly used as a ferry terminal for passengers looking to travel between New Bedford, Martha's Vineyard, Nantucket, Boston, New York City, and New London, CT. Steamship Pier is now primarily used for the berthing of commercial fishing vessels. It is comprised of three structures; an original pier, a pier extension constructed in 1986, and a timber boardwalk between Steamship pier and State Pier. The original structure was a 291-foot long timber pile supported pier, with timber stringers and decking. In 1977, reconstruction of the



original structure included encasing the original timber piles in reinforced concrete, construction of concrete stringers, and installation of a concrete deck. In 1986 the pier was extended 384 feet with a concrete deck supported by steel piles. The timber wharf is supported by timber piles and measures approximately 30 feet by 150 feet.

Existing drawings pertaining to the facility were located in the HDC Office. Prior inspection reports have not been located at the time of this writing.

## **SECTION 3 EXISTING CONDITIONS**

### *3.1 – General*

A visual inspection of the above water structures at Steamship Pier was performed by PARE Corporation on November 14 and 20, 2008. The topside inspections included a visual inspection of the timber Steamship Pier boardwalk, the original pier structure, the pier extension, and all fender systems at the pier. The inspection of the underside included a visual inspection of the piles and pile caps above the waterline as well as the underside of the deck along the Steamship Pier boardwalk, original pier structure, and pier extension. Photographs taken to document conditions observed during the inspections are available in Appendix A – Photographs. The underwater inspection of Steamship Pier was performed by Childs Engineering Corporation of Medfield, Massachusetts on November 14, 2008 in compliance with the *ASCE Underwater Investigations: Standard Practice Manual (2001)*.

For reference purposes, a baseline was established along the waterside face of the timber wharf and concrete pier during the inspection. Station 0+00 was located at the northeast corner of the timber wharf and extended to station 15+72 at the southwestern corner of the pier. Observations were made in relation to their location along the baseline as appropriate and as noted herein. A numbering system created during the underwater pile inspection is shown on Figure 2 – Site Plan. The numbering for the original pier structure begins with Bent No. 1 at the intersection with the Steamship Extension and finishes with Bent No. 36 at the final inshore pile bent. The Steamship Extension numbering begins with Bent No. 1 at the intersection with the original structure and continues to Bent No. 17 at the most outshore pile bent.

### *3.2 Original Structure*

The original structure measures approximately 291 feet long by 61 feet wide. Thirty-six pile bents contain between 8 and 10 piles each, with a total of 343 piles as shown in Figure 2 – Existing Pile Plan. The original piles are timber with a minimum 2-foot embedment into a reinforced concrete section. The timber piles have been jacketed with reinforced concrete to increase capacity and protect the timber, which is understood to have been reduced by rot and marine borer. An 18-inch by 15-inch reinforced concrete pile cap supports 10-inch thick concrete deck slabs. A 20-inch high by 16-inch wide concrete curb is provided along the perimeter of the pier. Cleats are bolted to the top of the timber fender system wale at approximate 25 foot intervals over the length of the pier.



The original pier structure and pier extension are protected with a timber fender system comprised of 10-inch diameter piles spaced 8-feet on center, 8-inch by 8-inch timber chocks at the tops of the piles, and two 2-inch by 12-inch timber caps. An 8-inch by 12-inch timber upper wale runs continuous between the chocks and the concrete curb. An 8-inch by 8-inch timber lower wale runs continuous, bolted to the piles at Mean Sea Level.

### 3.2.1 Original Pier - Topside

The concrete deck of the original structure was observed to be in overall fair condition, with observed deficiencies consisting of stress cracks, deteriorating concrete, and exposed steel reinforcement. Typically along the length of the original structure, both transverse and longitudinal cracks were observed in the concrete deck as shown in Photo 3 in Appendix A - Photographs. Longitudinal cracks were spaced 4 feet on center, with transverse cracks were spaced approximately 24 to 25 feet on center, corresponding to the precast plank deck joints. The sealer in the expansion joints is typically loose or missing, with soil and gravel now filling the joints.

### 3.2.2 Original Pier - Underwater

The original section of Steamship Pier was reconstructed circa 1977 to include a precast concrete deck and reinforced concrete jackets around the existing timber piles. The supporting piles of the original section were observed to be in generally fair to poor condition. A number of the concrete jackets are disintegrating. (According to available drawings, these jackets form the connection between the timber pile and the concrete pile caps, and the concrete jackets actually form a concrete column above the top of the timber pile and below the concrete cap). Several of the jackets (ten) have completely broken down and only have the steel reinforcing cage remaining leaving the timber pile exposed. Other jackets have concrete section loss which exposes the rebar, both above and below the waterline. Some of the timber piles are exposed from one to four feet beneath the concrete jacket, and exhibit evidence of marine borer attack. Several piles have reduced pile diameters in this area, with the majority of the piles observed to display solid timber. Appendix A – Photographs indicates typical conditions encountered.

## 3.3 *Pier Extension*

The pier extension has added an additional 384-feet to the end of the original structure. The extension is approximately 38-feet wide for 288 feet. It then widens to approximately 63.5-feet wide for the remaining 96 feet. Seventeen pile bents are spaced 24-feet on center with 99 vertical piles and 32 batter piles. The piles are 16-inch diameter pipe piles filled with concrete. The pile caps are 32-inches wide by 30-inches deep and support 12-inch thick concrete deck slabs with a concrete curb that matches the curb on the original structure.



### 3.3.1 Pier Extension - Topside

Along the pier extension, the concrete deck was observed to be in generally fair to poor condition with several surface cracks observed. Several locations along the deck surface have spalled exposing the steel reinforcement, with significant spalling typically observed surrounding the expansion joints. Asphalt patching used during previous repairs was observed, typically with additional spalling of the concrete surrounding the patchwork as shown in Photos 9 and 10 in Appendix A. Spalling was observed at the edge of the deck from Station 6+56 to 6+62, Station 7+10, and Station 7+38. Specific locations of large spalls and other damage are listed in Appendix F – Field Notes.

The Steamship Pier extension was constructed around 1986 with precast concrete deck panels, concrete pile caps, and steel pipe piles filled with concrete. The extension is in overall good condition. The steel piles have significant coating remaining. There has been no significant loss of steel section. The underside of the concrete deck was observed to be in generally good condition. The concrete caps were observed to be in generally satisfactory condition, with typical areas of spalling and efflorescence noted along the caps.

### 3.3.2 Pier Extension - Underwater

The underwater inspection of the Pier Extension piles indicated that the steel piles are in generally good condition with no significant loss of steel section. Ultrasonic thickness (UT) and cathodic potential (CP) readings were taken along the steel pipe piles and steel sheet pile bulkhead. Readings were taken at the mudline, mean low water, and approximately halfway between the two. The following tables illustrate the results.

Table 3.2 – Steel Pipe Piles Underwater Readings

<b>STATION</b>	<b>ELEVATION</b>	<b>UT Q1</b>	<b>UT Q2</b>	<b>UT Q3</b>	<b>UT Q4</b>	<b>CP</b>
BENT 13 PILE 1	Mud	0.360	0.330	0.330	0.335	0.490
	Mid	0.370	0.370	0.365	0.365	0.488
	MLW	0.395	0.365	0.375	0.370	.175-.430
BENT 11 PILE 1	Mud	0.320	0.325	0.330	0.330	0.507
	Mid	0.370	0.390	0.360	0.370	0.502
	MLW	0.370	0.370	0.370	0.360	0.516
BENT 13.5 PILE1	Mud	0.305	0.320	0.340	0.325	0.458
	Mid	0.370	0.355	0.360	0.365	0.448
	MLW	0.370	0.370	0.365	0.365	0.449
BENT 16 PILE 1	Mud	0.320	0.330	0.325	0.320	0.446
	Mid	0.370	0.360	0.350	0.360	0.445
	MLW	0.370	0.370	0.370	0.370	0.454
BENT 9 PILE 1	Mud	0.325	0.330	0.315	0.330	0.511
	Mid	0.350	0.370	0.360	0.370	0.510
	MLW	0.335	0.380	0.345	0.365	0.500
BENT 7	Mud	0.345	0.345	0.360	0.365	0.508



PILE 7	Mid	0.370	0.375	0.375	0.380	0.508
	MLW	0.365	0.365	0.370	0.380	0.510
BENT 5 PILE 1	Mud	0.335	0.340	0.345	0.330	0.513
	Mid	0.365	0.385	0.380	0.375	0.514
	MLW	0.380	0.390	0.370	0.380	0.565
	BENT 3 PILE 1	Mud	0.350	0.345	0.345	0.345
	Mid	0.365	0.365	0.365	0.365	0.324
	MLW	0.360	0.360	0.360	0.365	0.351
BENT 1 PILE 1	Mud	0.310	0.310	0.300	0.315	0.340
	Mid	0.380	0.375	0.380	0.380	0.349
	MLW	0.375	0.375	0.375	0.375	0.300

### 3.4 Timber Boardwalk

The timber boardwalk component of the structure runs parallel to the shoreline between State Pier and Steamship Pier. The wharf is supported by 12-inch diameter timber piles, 12-inch by 12-inch timber pile caps, and 4-inch by 8-inch timber stringers. The landside end of the pile caps is supported by a 16-inch by 4.5-inch by 0.75-inch double channel steel wale mounted to the face of a steel sheetpile bulkhead. The steel sheet bulkhead is retained by two inch diameter tie backs at approximate 10 foot intervals. The deck is comprised of 1-inch by 6-inch timber boards with a 12-inch by 12-inch timber curb along the waterside edge.

#### 3.4.1 Boardwalk - Topside

The timber pile supported wharf extends from Station 0+00 to Station 1+54. The timber decking was observed to be in overall good to fair condition. Mildew growth was typical along the topside of the deck with some splintering and warping of the boards noted during the inspection. The pile caps extended approximately 12 inches beyond the waterside face of the wharf, with many of the ends damaged due to rot and possible impact from vessels. The timber curb was observed to be in fair condition, with rotting of the timber observed near Station 0+75, minor wear along the length, and a displaced section from Station 1+24 to Station 1+54. Four cleats were observed bolted to the top of the curb, however, two of them were damaged with bent bolts and broken timber at Station 0+94 and Station 1+09. A steel ladder that allowed access to a small floating dock was noted at Station 0+78. The ladder was observed to be in good to fair condition but was missing the connecting bolts and was held in place on the face of the wharf with a galvanized chain.

Beneath the timber wharf, the shoreline is retained by a steel sheetpile bulkhead. The bulkhead was observed to be in overall fair condition, with corroded steel and loss of the steel coating. A double channel steel wale runs along the face of the bulkhead and supports the timber pile caps at their landside end. The steel wale was observed to be in poor condition, with significant corrosion and 100% section loss observed in several locations.



### 3.4.2 Boardwalk - Underwater

The Steamship Boardwalk is supported timber pile bents comprised of 3 evenly spaced timber piles. Atop the piles is a timber cap that is supported at the inshore edge by the steel bulkhead wale. The timber piles are in generally good condition, with a few out-shore piles exhibiting section loss due to abrasion from floating docks which are tied alongside. The out-shore end of the pile caps are typically rotted and split starting between pile 2 and pile 3 to the end which is cantilevered 1 to 2 feet beyond pile 3. The timber bracing is in good condition; however the lower connection hardware has typically 50% loss of the steel on the lower connections.

The steel sheet pile bulkhead is in fair condition. There is typically a ¼ inch of corrosion byproduct build up, pitting of the steel up to 1/8 inch deep and ½ inch wide, and low potential readings around 0.3 volts indicating a high corrosion potential. The steel sheet pile section located at station 0+00 has very thin steel readings at the mudline with less than a ¼ inch of steel thickness found in this area. It was noted that the sheet pile sections at this location are a different steel section than the remaining bulkhead section. The wall has an external wale with 2” diameter tierods spaced at 10ft intervals. The wale also supports a 12x12 timber pile cap which is the inshore support of the timber pier. There is an outfall in the steel sheet pile bulkhead located between bents 10 and 11 of the steamship boardwalk. The bulkhead runs out along the outfall in this location and is supported by steel struts 6 feet on center. The steel struts are in good condition. The bulkhead that flanks the outfall acts as the pier support for bents 10 and 11. The 12x12 timber cap is set along the top of the sheeting and supports the stringers between these bents.

Table 3.3 – Steel Sheet Pile Underwater Readings

STATION	ELEVATION	UT	UT	UT	CP
		<i>Inner Flange</i>	<i>Web</i>	<i>Outer Flange</i>	
0+00	Mud	0.305	0.245	0.225	0.304
	Mid	n/a	n/a	n/a	no reading
	MLW	0.325	0.335	0.330	0.303
0+68	Mud	0.520	0.375	0.500	no reading
	Mid	0.515	0.365	0.505	no reading
	MLW	0.515	0.370	0.510	no reading

STATION	ELEVATION	UT	UT	UT	CP
		<i>Inner Flange</i>	<i>Web</i>	<i>Outer Flange</i>	
0+00	Mud	0.305	0.245	0.225	0.304
Bulkhead Corner	Mid	n/a	n/a	n/a	
6' of Water	MLW	0.325	0.335	0.330	0.303
Bent 4	Mud	0.520	0.375	0.500	
0+68	Mid	0.515	0.365	0.505	



	MLW	0.515	0.370	
Bent 18	Mud	0.415	0.280	0.319
1+82	Mid	0.420	0.205	0.306
	MLW	0.520	0.355	

### 3.5 Fender System and Appurtenances

The fender system was observed to be in overall fair to poor condition. The 10-inch diameter fender piles were observed to be in good to fair condition, with several areas in poor condition. The timber chocks, upper wale, and fender cap were observed to be in overall fair to poor condition. Typical deficiencies consist of wearing of the pile faces and several missing and broken piles. Many of the timber chocks and several sections of the timber fender cap were broken or missing. Fire damage was observed on the fender cap at Station 4+94, creating a 12-inch diameter hole in the cap. Another fire has caused significant damage to the fender cap, upper wale, and chocks at Station 8+28. Typical fender system damage is shown in Photo 5 in Appendix A - Photographs. On the top of the upper wale, 24-inch long cleats were observed spaced 24 feet on center. It was noted during the inspection that numerous cleats were loose, with either bent connection bolts or damaged timber. Specific locations of broken and/or missing piles and chocks observed during the topside inspection are listed in the table below.

Table 3.1 – Fender Deficiencies

Location	Station	Deficiency	Description
Topside	2+31 - 2+39	Timber Chock	Damaged / Broken
Topside	2+87 - 2+95	Timber Chock	Missing
Topside	3+03 - 3+11	Timber Chock	Missing
Topside	3+49	Timber Chock	Significantly worn
Topside	3+68	Timber Fender Pile	Missing
Topside	3+68	Timber Chock	Broken
Topside	4+17 - 4+25	Timber Chock	Missing
Topside	4+94	Timber Fender Pile	Fire damage to top of pile
Topside	5+18 - 5+26	Timber Chock	Missing
Topside	6+22 - 6+30	Timber Chock	Missing
Topside	6+54	Timber Fender Pile	Significantly worn
Topside	8+03	Timber Chock	Broken
Topside	8+06	Timber Fender Pile	Broken
Topside	8+24	Timber Chock	Missing
Topside	8+28	Timber Chock	Fire damage
Topside	8+36	Timber Chock	Missing
Topside	8+41 - 8+49	Timber Chock	Missing
Topside	8+81	Timber Fender Pile	(3) Significantly worn
Topside	9+76	Timber Fender Pile	Broken at MLW
Topside	9+76	Timber Chock	Missing
Topside	9+96	Timber Chock	Missing
Topside	10+60	Timber Fender Pile	Significantly worn
Topside	10+60 - 10+68	Timber Chock	Missing
Topside	11+41	Timber Chock	Missing
Topside	11+45	Timber Chock	Missing
Topside	12+41	Timber Chock	Significantly worn



Topside	12+98	Timber Chock	Missing
Topside	13+10	Timber Chock	Broken
Topside	13+87	Timber Chock	Broken / Significantly worn

Below water, the timber fender system is in fair condition. There are a number of broken fender piles and other broken timber members. Most of the piles show evidence of section loss due to abrasion. The timber members are solid below water with no observed punkiness.

The concrete curb houses a utility raceway that provides electricity to electrical outlets along the curb face and light posts mounted on top of the curb. Access boxes were typically located approximately 4 to 6 feet from each outlet and light post. From Station 5+42 to Station 5+58, spalling was observed on the face and on the top of the curb with no exposed reinforcement noted.

Galvanized steel ladders and life rings were observed along the original structure and pier extension. The ladders are mounted within the fender system and provide access to and from the deck and the water below. Overall the ladders were observed to be in fair to poor condition. Many of the ladders have been damaged during impact with vessels causing damage to the rungs and buckling of members. All of the ladders are corroded below mean high water rendering them useless during times of low water. The life rings were observed mounted to the face of the concrete curb, providing access to emergency life-saving devices.

A list of specific locations of all fenders, ladders, cleats, light posts, electrical outlets, and life rings as well as any other deficiencies observed during the topside inspection is provided in Appendix E: Field Notes.

## **SECTION 4 – STRUCTURAL CONDITION ASSESSMENT**

### **4.0 – Structural Condition Assessment**

#### *4.1 General*

Based on the observations obtained from the site inspections, the following provides our assessment of the various structures and components. Existing structure conditions were based on visual and tactile observations only, and were limited to accessible and visible portions of the structures.

#### *4.2 Original Pier*

The Original Pier component of the Steamship Pier was observed to be in generally fair condition, with observed deficiencies as described below:

- Cracking of the concrete deck is symmetrical with the precast concrete deck panels, and is typical of this type of construction. Lateral loads causing deflection of the pier





structure induce movement in the precast slabs, causing cracking of the concrete deck overlay.

- The concrete caps are in fair condition, with localized areas of repair required.
- The concrete encasements (jackets) on the timber piles were observed to have areas of deficiencies as indicated on Figure 2 – Existing Site Plan. The loss of concrete section exposing reinforcing steel above the waterline must be repaired or replaced, as this area comprises a structural column and is required for the support of the pier. The loss of concrete cover on the underwater sections of the concrete encasements is not as critical, as this area of concrete serves primarily as a protection to the timber.
- Loss of timber pile section was observed in areas where the concrete encasements do not extend to the mudline. While this can be a potentially serious situation, the observed remaining pile diameters were generally good, with few exceptions, and solid timber was observed.
- Missing or disconnected pile bracing.

Given the age and existing condition of the pier, the original section of the Steamship Pier could be considered as nearing the end of its useful life. If neglected, the deterioration of the concrete encasements will result in a reduced load carrying capacity of the pier, requiring the eventual reconstruction of this component of the pier. However, with remedial work and continued monitoring, the remaining life of the structure can be extended.

Recommended remedial measures include the replacement of deteriorated concrete pile encasements, extension of concrete jackets to the mudline where pile diameters have been significantly reduced, and repair of limited cracking and spalling of the reinforced concrete pile caps. It is also recommended that the piles be inspected at regular intervals of approximately 3 years, to monitor further deterioration of the concrete encasements and deterioration of the unprotected areas of the timber piles.

#### *4.3 Pier Extension*

The steel pile supported Pier Extension was constructed in 1986 and is in generally good condition. The concrete deck was observed to have localized areas of spalling adjacent to the expansion joints which need to be addressed. The concrete pile caps were observed to have localized areas of spalling. The steel pipe piles were observed to be in generally good condition, with ultrasonic thickness readings on the steel pipe piles indicating very little section loss to date. Higher rates of corrosion were observed near the mudline. The installation of cathodic protection along the piles will reduce the rate of steel corrosion and therefore increase the life span of the structure.

Recommendations for this component of the structure include the repair of spalling and exposed reinforcing steel of the concrete deck and pile caps, and the installation of a cathodic protection system for the steel piles.



#### 4.4 Timber Boardwalk

The existing timber boardwalk was observed to be in generally fair condition, with several areas of rehabilitation required. The timber piles were observed to be in generally good condition, with little evidence of marine borer. The existing lower bolts on the pile bracing are corroded and replacement is warranted. The timber pile caps are deteriorated above the outer row of piles, and need to be reinforced or replaced. The steel wale ledger beam along the inshore face of the sheeting is corroded and needs to be reinforced or replaced. The steel sheet piling is corroded and has a slight loss of steel section. Cathodic protection of the steel sheet piling is recommended to extend its useful life.

#### 4.5 Fendering and Appurtenances

The existing fender system is in fair condition, with replacement of broken fender piles and wales and chocks required to adequately protect the structure and vessels. Similarly, the existing ladders should be repaired and replaced. The existing cleats have rotated in many instances and should be replaced with more substantial hardware fastened to the concrete.

### SECTION 5 RECOMMENDATIONS AND OPINION OF PROBABLE COST

#### 5.1 – Recommendations - General

Based on conditions observed during the inspections, and the corresponding assessments of the existing structures, the following recommendations are provided for the repair and rehabilitation of these structures. Existing structure conditions and assessments were based on visual and tactile observations only, and were limited to accessible and visible portions of the structures.

Opinions of probable cost were generated based upon current industry unit prices for similar work. Breakdowns of cost are provided in the Appendix. The opinions provided are for construction only and do not include allowances for engineering, permitting, or construction administration. A 20 percent contingency has been included with these costs. The opinions shown herein are based on a limited investigation and are provided for general information only. This should not be considered an engineer's estimate, as actual construction costs may be somewhat less or considerably more than indicated, due to fluctuations in the market and the actual repair implemented.

#### 5.2 – High Priority

The following items are considered to have a High Priority, as they affect the usability and safety of the structure:



A. Rehabilitate Original Structure Piles

This item consists of the encasement of the severely deteriorated piles supporting the original structure of Steamship Pier. Providing “fish plates” or concrete jackets as means of repair is the most viable option at this site. Similar repairs to the piles beneath the pier were completed in the past.

The proposed work will require excavation to uncover the section of good pile below the mudline, and will include the encasement of the piles with reinforced concrete within fiberglass forms. The opinion of probable construction cost for this work is approximately \$278,000.

Alternatively, the replacement of the entire original structure with concrete filled pipe piles similar to the pier extension has an associated opinion of probable construction cost of approximately \$3,250,000.

B. Reattach Cross Bracing

This item consists of the removal and replacement of low water connection hardware for the cross bracing. Loose cross bracing beneath the original structure and timber boardwalk needs to be reattached. The opinion of probable construction cost for this work is approximately \$30,000.

C. Fender Repairs

This item consists of the removal of broken fendering members and replacement with new timber. This includes removal of old hardware, disposal of materials, and the furnishing and installation of new hardware and timber members. The opinion of probable construction cost for this work is approximately \$150,000.

D. Concrete Deck Repairs

This item consists of repairs to the deteriorated concrete deck along the pier extension. The proposed work will include patching spalled areas and installation of joint filler. The opinion of probable construction cost for this work is approximately \$25,000.

*5.3 – Lower Priority*

The following items are considered to have a Lower Priority, as they presently do not affect the usability and safety of the structure, but will need to be addressed in approximately 5 to 10 years.

A. Installation of Cathodic Protection




This item consists of the installation of cathodic protection along the steel sheetpile bulkhead beneath the timber boardwalk and on the steel pipe piles beneath the pier extension. Sacrificial zinc or aluminum anodes minimize corrosion of the steel sheet piling and components, as well as the steel pipe piles, and will extend the useful life of the structures. The opinion of probable construction cost for this work is approximately \$105,360.



***Figures***  
*Steamship Pier*  
*New Bedford, Massachusetts*



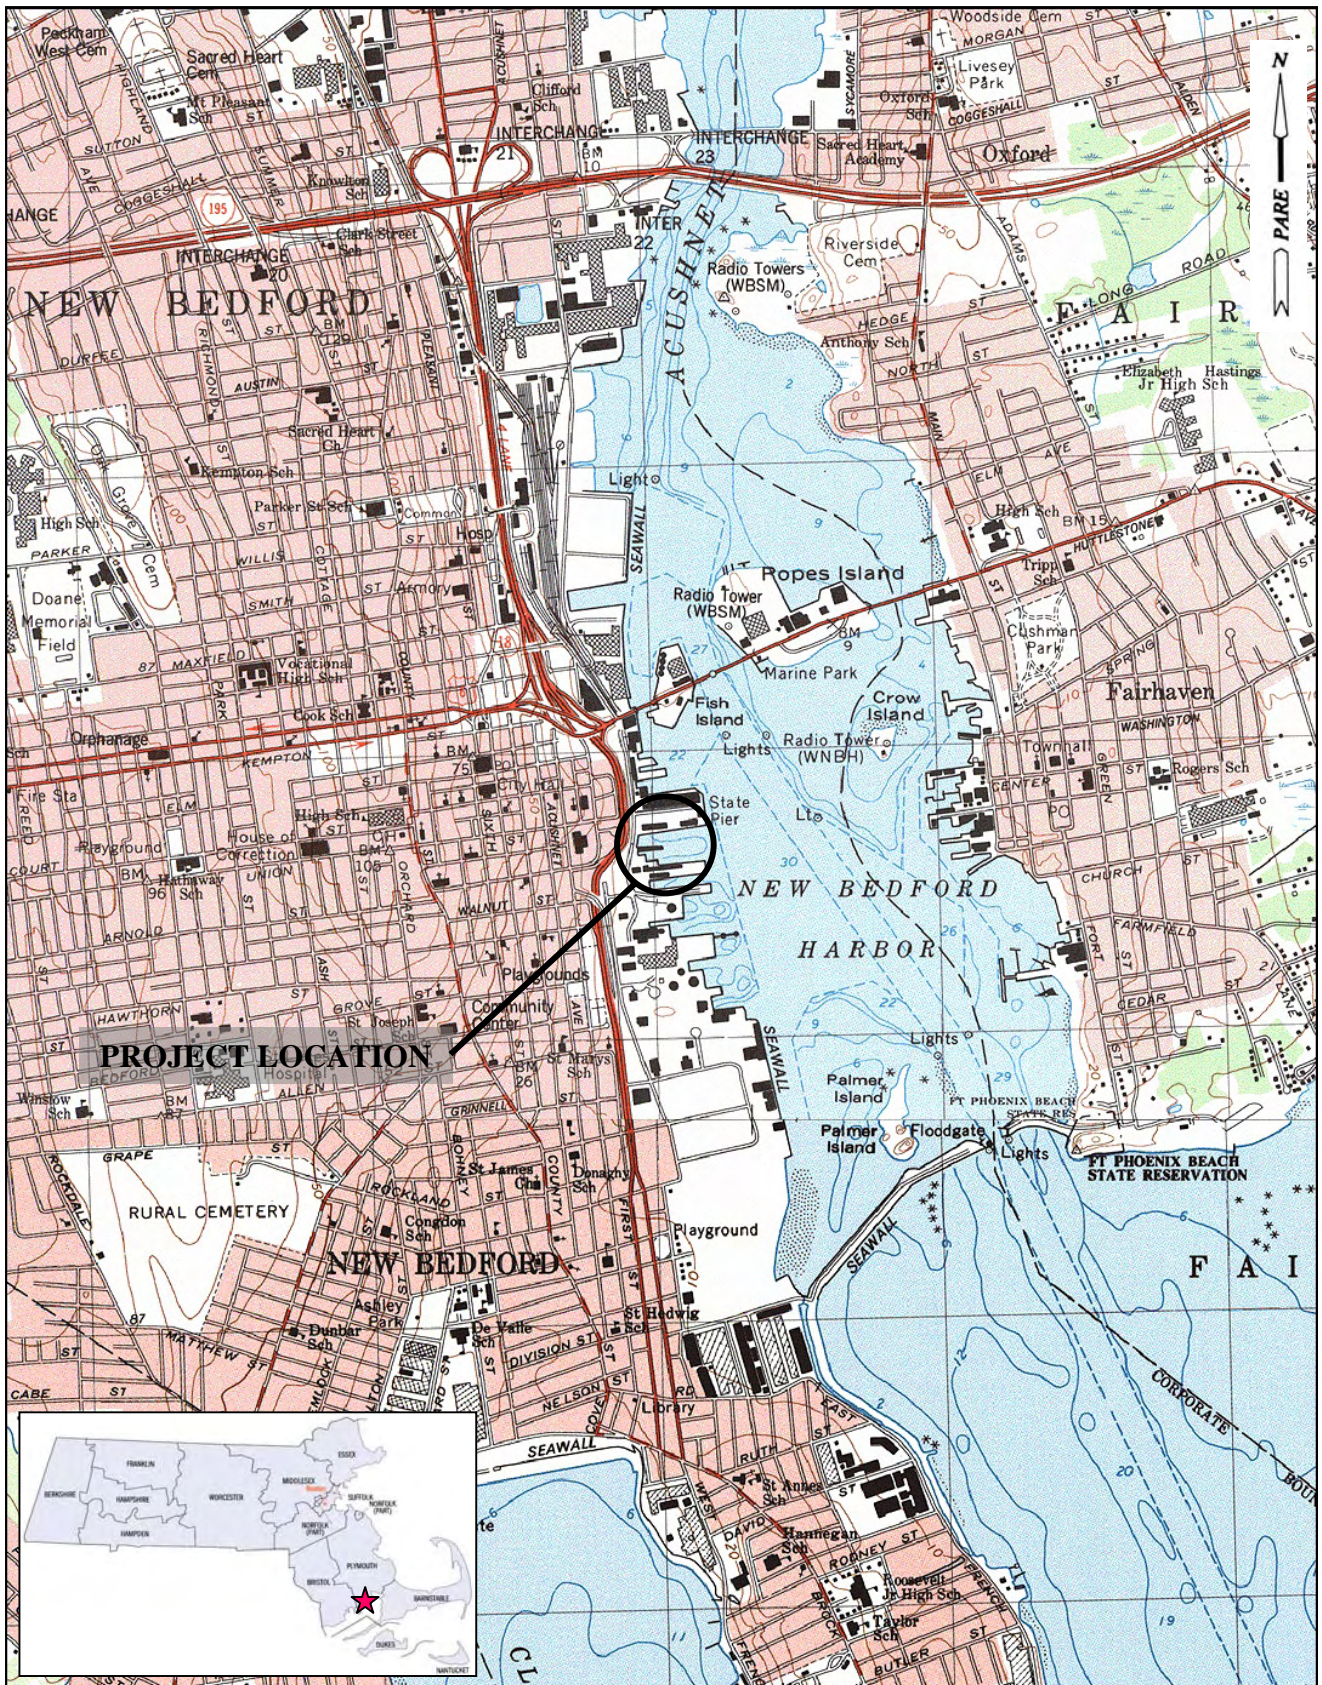

0 1000 FEET 0 1/2 500 m 1000 m  
 Printed from TOPO! ©1999 Wildflower Productions (www.topo.com)



**STEAMSHIP PIER**  
**NEW BEDFORD, MASSACHUSETTS**  
 NEW BEDFORD HARBOR DEVELOPMENT COMMISSION  
 NEW BEDFORD WATERFRONT FACILITY INSPECTIONS  
 NOVEMBER 2008

**FIGURE 1**  
**LOCUS PLAN**



**NEW BEDFORD WATERFRONT  
 FACILITIES INSPECTIONS  
 STEAMSHIP PIER**  
 NEW BEDFORD HARBOR DEVELOPMENT COMMISSION  
 NEW BEDFORD, MASSACHUSETTS


REVISIONS:


PROJECT NO.: 08216.00  
 DATE: NOVEMBER 2008  
 SCALE: AS NOTED  
 DESIGNED BY: -  
 CHECKED BY: -  
 DRAWN BY: RMM  
 APPROVED BY: KWH  
 DRAWING TITLE:

STATE PIER



MACARTHUR DRIVE

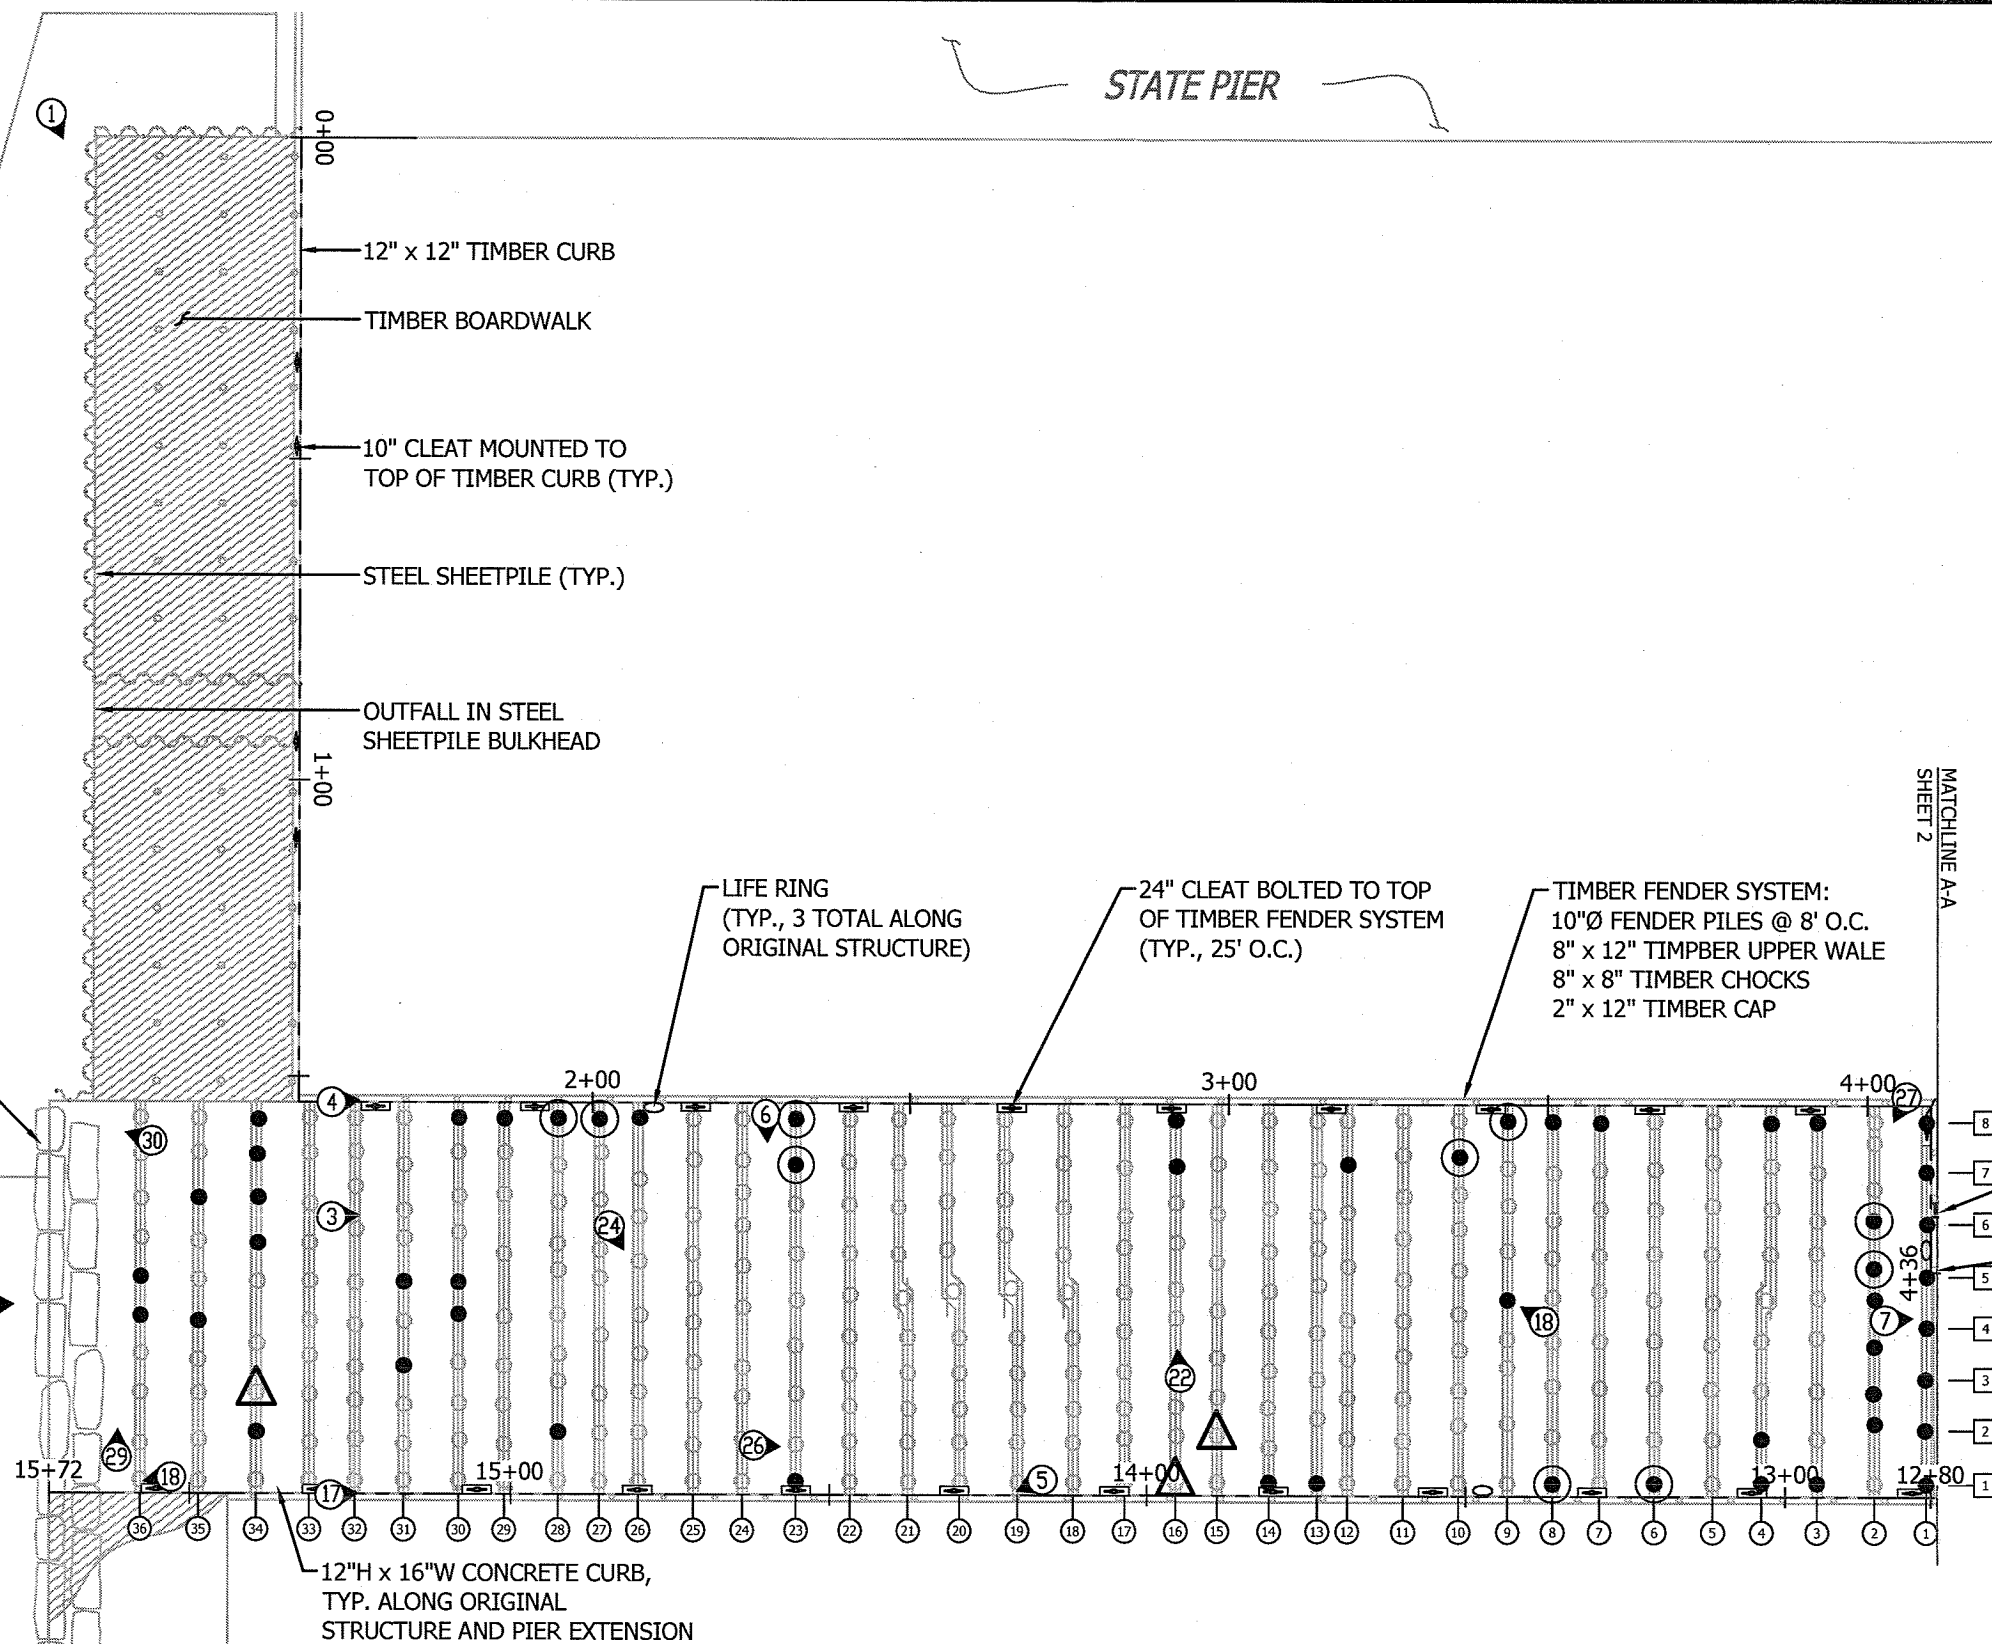

GRANITE BLOCK WALL  
 BENEATH PIER

COAL POCKET  
 PIER


- LEGEND:**
- ⑧ APPROXIMATE PHOTO LOCATION AND DIRECTION
  - ⑩ BENT NUMBER
  - ① PILE NUMBER
  - 10+00 BASELINE/STATION
  - ▬ CLEAT
  - ┆ LADDER

- SUPPORT PILE LEGEND:**
- ⊙ ENCASUREMENT DETERIORATED WITH EXPOSED TIMBER PILE (10)
  - ENCASUREMENT DETERIORATED IN TIDAL ZONE (41)
  - △ MUDLINE EXPOSED WITH LESS THAN 6" OF TIMBER PILE SECTION REMAINING (3)

- NOTES:**
1. TOPSIDE CONDITIONS INSPECTION PERFORMED BY PARE PERSONEL ON NOVEMBER 14, 2008.
  2. UNDERWATER CONDITION INSPECTION PERFORMED BY CHILDS ENGINEERING CORP. ON NOVEMBER 14, 2008.
  3. SITE PLAN BASED UPON DRAWINGS ENTITLED "STRUCTURAL DETAILS - CONSTRUCTION OF STEAMSHIP PIER AND COALPOCKET PIER" BY TIBBETTS ENGINEERING CORP. DATED JUNE, 1977, "STRUCTURAL DETAILS - EXTENSION OF STEAMSHIP PIER" BY TIBBETTS ENGINEERING CORP. DATED MARCH 1986, AND CONDITIONS OBSERVED DURING THE INSPECTION.

HALF SIZED

**NEW BEDFORD WATERFRONT  
 FACILITIES INSPECTIONS  
 STEAMSHIP PIER**  
 NEW BEDFORD HARBOR DEVELOPMENT COMMISSION  
 NEW BEDFORD, MASSACHUSETTS

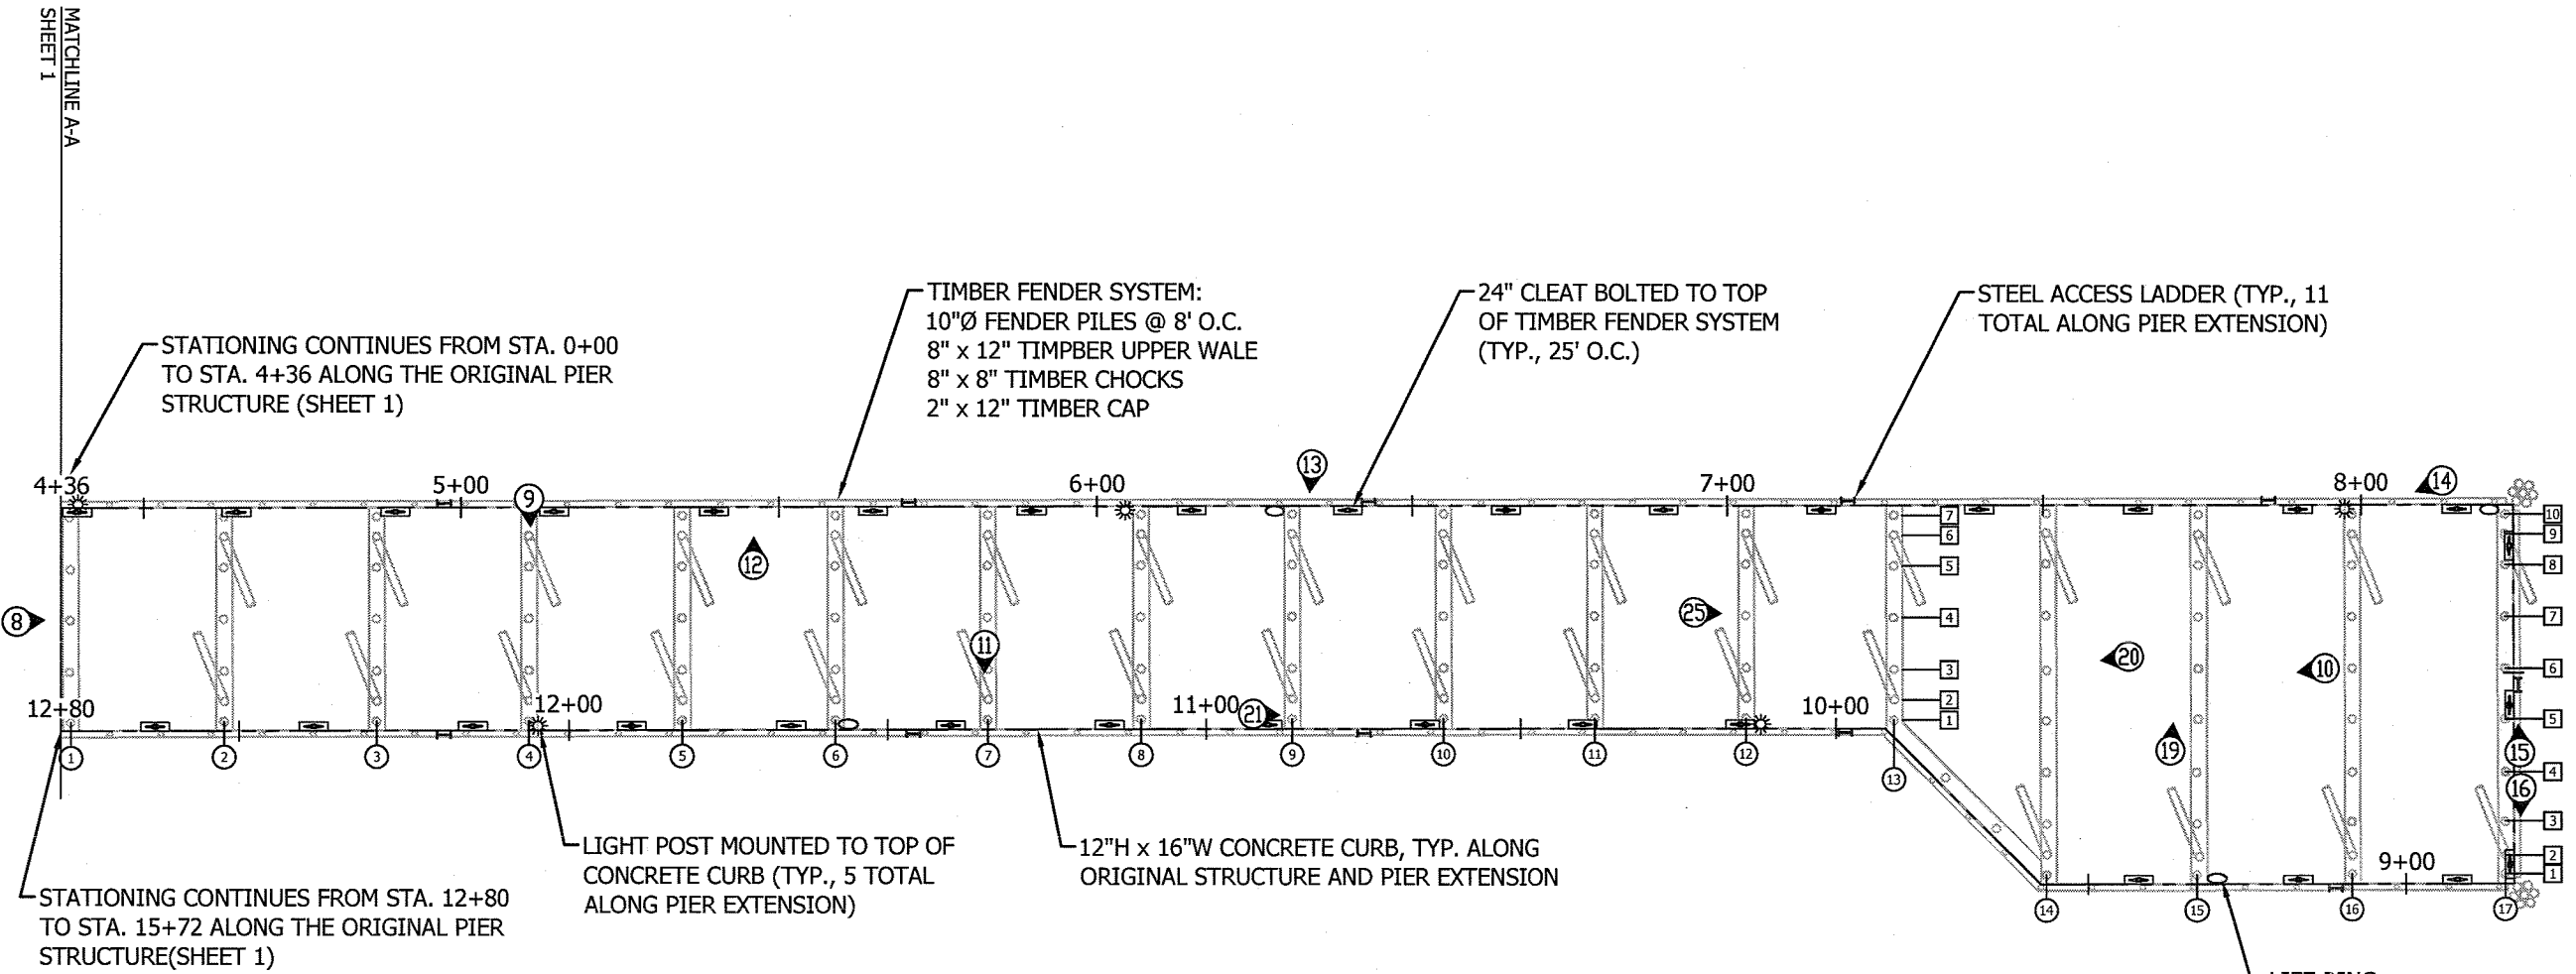

STATIONING CONTINUES FROM STA. 0+00 TO STA. 4+36 ALONG THE ORIGINAL PIER STRUCTURE (SHEET 1)

STATIONING CONTINUES FROM STA. 12+80 TO STA. 15+72 ALONG THE ORIGINAL PIER STRUCTURE (SHEET 1)

TIMBER FENDER SYSTEM:  
 10"Ø FENDER PILES @ 8' O.C.  
 8" x 12" TIMBER UPPER WALE  
 8" x 8" TIMBER CHOCKS  
 2" x 12" TIMBER CAP

24" CLEAT BOLTED TO TOP OF TIMBER FENDER SYSTEM (TYP., 25' O.C.)

STEEL ACCESS LADDER (TYP., 11 TOTAL ALONG PIER EXTENSION)

LIGHT POST MOUNTED TO TOP OF CONCRETE CURB (TYP., 5 TOTAL ALONG PIER EXTENSION)

12"H x 16"W CONCRETE CURB, TYP. ALONG ORIGINAL STRUCTURE AND PIER EXTENSION

LIFE RING (TYP., 4 TOTAL ALONG PIER EXTENSION)

BUZZARDS BAY

- LEGEND:**
- ⑧ APPROXIMATE PHOTO LOCATION AND DIRECTION
  - ⑩ BENT NUMBER
  - 1 PILE NUMBER
  - 10+00 BASELINE/STATION
  - ▬ CLEAT
  - ┆ LADDER

- NOTES:**
1. CONDITIONS INSPECTION PERFORMED BY PARE PERSONEL ON NOVEMBER 14, 2008.
  2. UNDERWATER CONDITION INSPECTION PERFORMED BY CHILDS ENGINEERING CORP. ON NOVEMBER 14, 2008.
  3. SITE PLAN BASED UPON DRAWINGS ENTITLED "STRUCTURAL DETAILS - CONSTRUCTION OF STEAMSHIP PIER AND COALPOCKET PIER" BY TIBBETTS ENGINEERING CORP. DATED JUNE, 1977, "STRUCTURAL DETAILS - EXTENSION OF STEAMSHIP PIER" BY TIBBETTS ENGINEERING CORP. DATED MARCH 1986, AND CONDITIONS OBSERVED DURING THE INSPECTION.

REVISIONS:	
PROJECT NO.:	08216.00
DATE:	NOVEMBER 2008
SCALE:	AS NOTED
DESIGNED BY:	-
CHECKED BY:	-
DRAWN BY:	RMM
APPROVED BY:	KWH
DRAWING TITLE:	EXISTING SITE PLAN PIER EXTENSION
FIGURE NO.:	3
SHEET NO.	2 OF 2

HALF SIZED



*Appendix A*  
*Photographs*  
*Steamship Pier*  
*New Bedford, Massachusetts*



Photo No. 1: Timber wharf from Station 0+00 to Station 1+54.



Photo No. 2: Overview of the Steamship Pier.





Photo No. 3: Typical longitudinal and transverse cracking observed along the deck of the original structure.

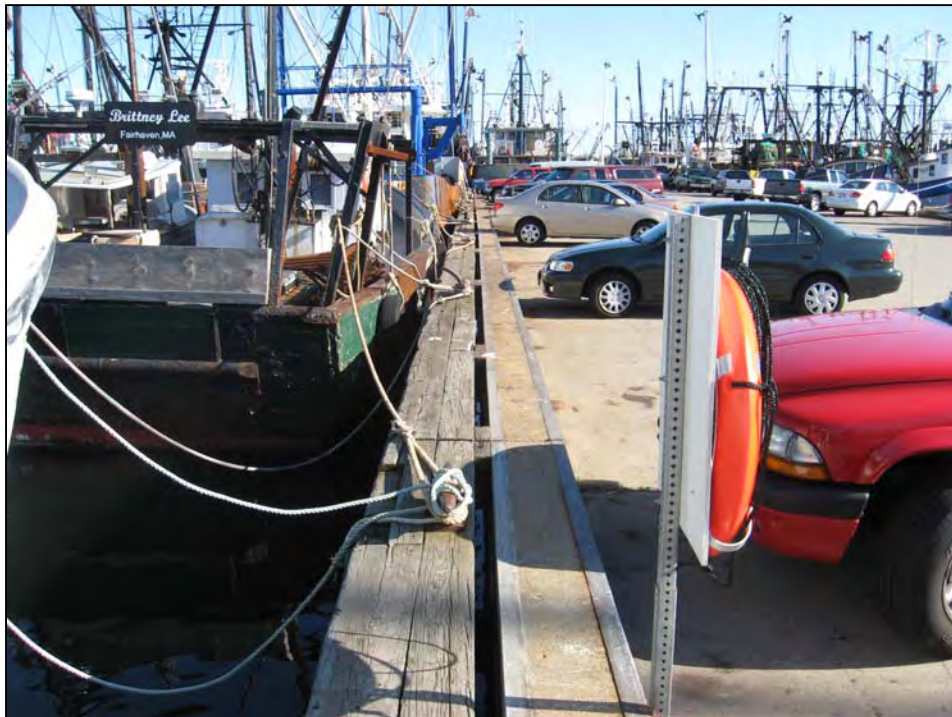


Photo No. 4: Overview of the concrete curb and fender system on the north face of the pier.



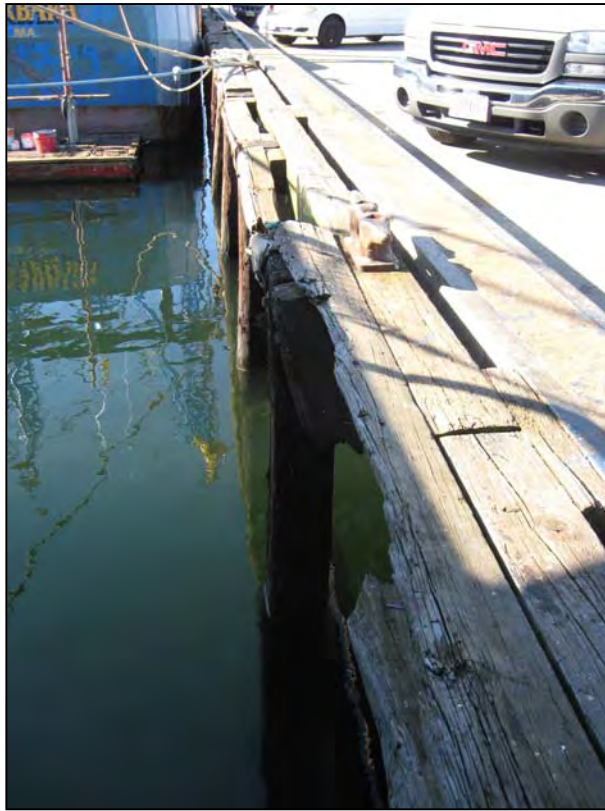


Photo No. 5: Typical fender section with broken chock and damaged or missing cap board.



Photo No. 6: Typical expansion joint in the deck of the original structure. Note missing joint sealer.



Photo No. 7: Loose joint filler at intersection of original structure and pier extension.

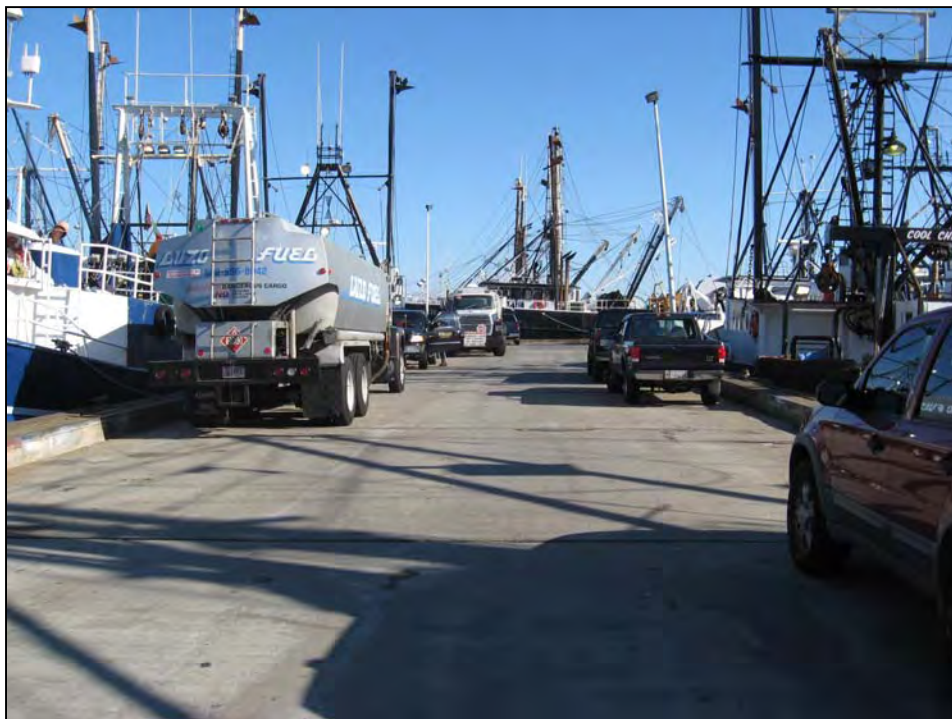


Photo No. 8: Overview of the pier extension.





Photo No. 9: Typical expansion joint in the deck of the pier extension. Note spalling of concrete and asphalt patch.



Photo No. 10: Four way intersection of expansion joints at the head of the pier extension.





Photo No. 11: Spalling of the concrete deck with exposed reinforcement observed in several locations.

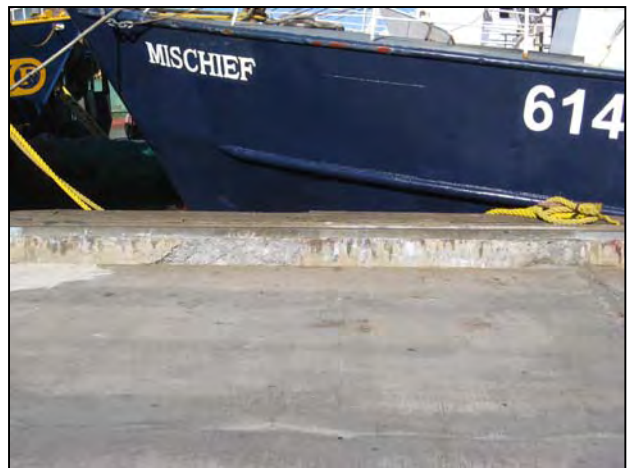


Photo No. 12: Spalling of concrete on top and face of curb.



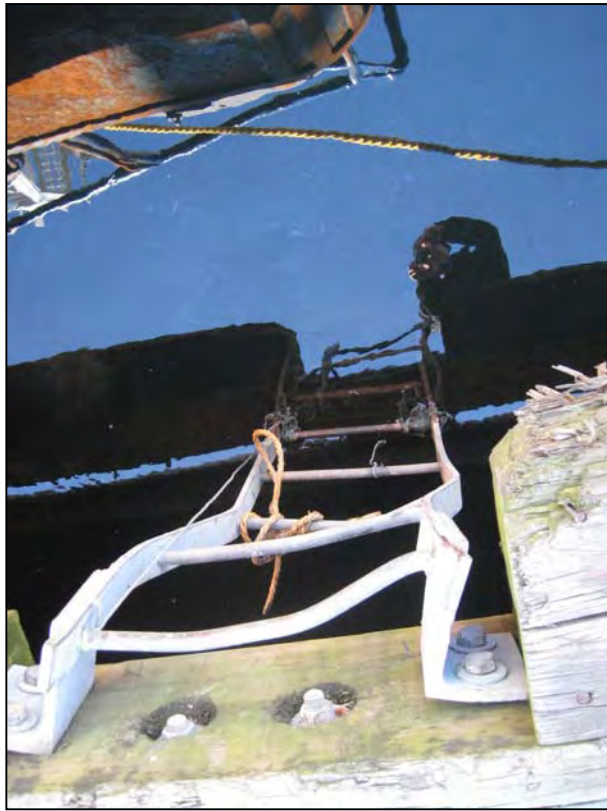


Photo No. 13: Typical buckled ladder.

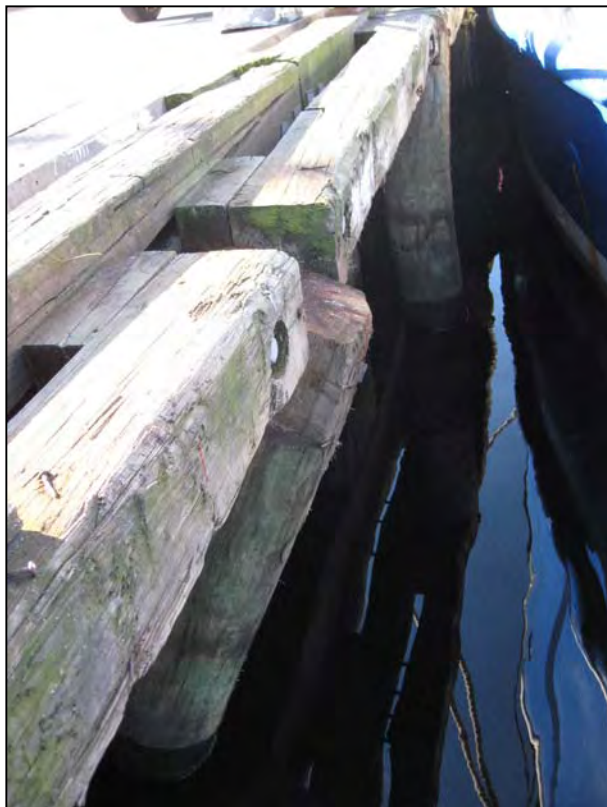


Photo No. 14: Broken fender pile at Station 8+06.



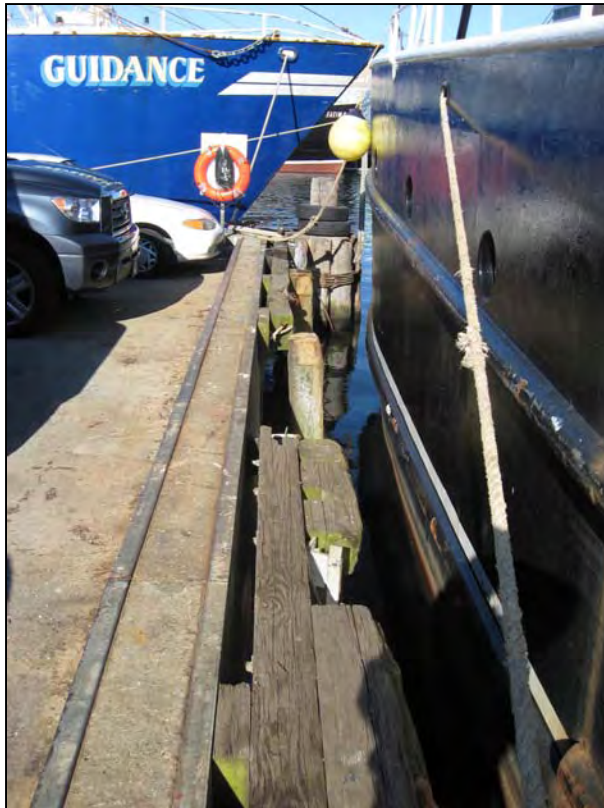


Photo No. 15: Damaged fender system from station 8+20 to Station 8+65.

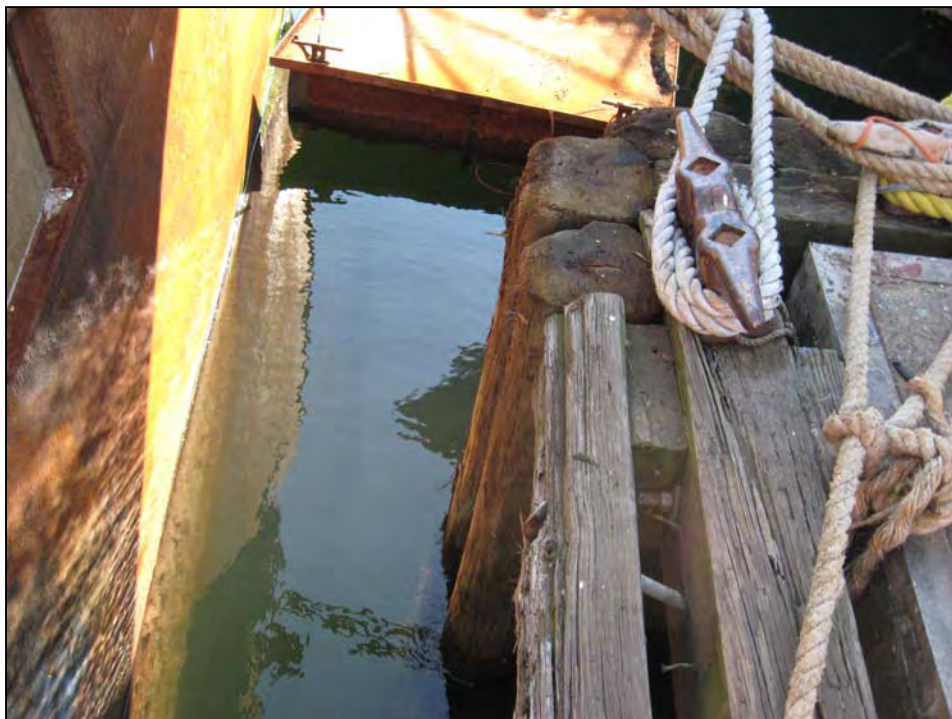


Photo No. 16: Worn fender piles and loose cleat at Station 8+80.



Photo No. 17: Overview of the curb and fender system on the south face of the pier.



Photo No. 18: Patch in the southwest corner of the concrete deck.





Photo No. 19: Typical overview of the deck slabs, concrete pile caps, and piles below the pier extension.



Photo No. 20: Typical spalling of the pile cap beneath the pier extension. Note presence of efflorescence.





Photo No. 21: Significant spalling of the concrete pile cap along the waterside edge beneath the original pier structure. Note exposed reinforcement.



Photo No. 22: Typical spalling of the underside of the pile cap beneath the original pier structure.



Photo No. 23: Spalled areas on the concrete pile cap with rust staining from exposed steel reinforcement.



Photo No. 24: Cracking at the top of the concrete pile beneath the original pier structure.







Photo No. 25: Typical top of pile at the intersection of the concrete pile cap beneath the pier extension.



Photo No. 26: Missing concrete jacket with exposed steel reinforcement cage and timber pile. (Photo by Childs Engineering Corp.)



Photo No. 27: Missing concrete jacket with exposed steel reinforcement cage and timber pile.



Photo No. 28: Missing concrete jacket with exposed steel reinforcement cage in the tidal zone.





Photo No. 29: Overview of the granite block wall along the shoreline beneath the original structure looking north.



Photo No. 30: Overview of the void at the corner of the granite block wall and the steel sheetpile bulkhead under the timber boardwalk.





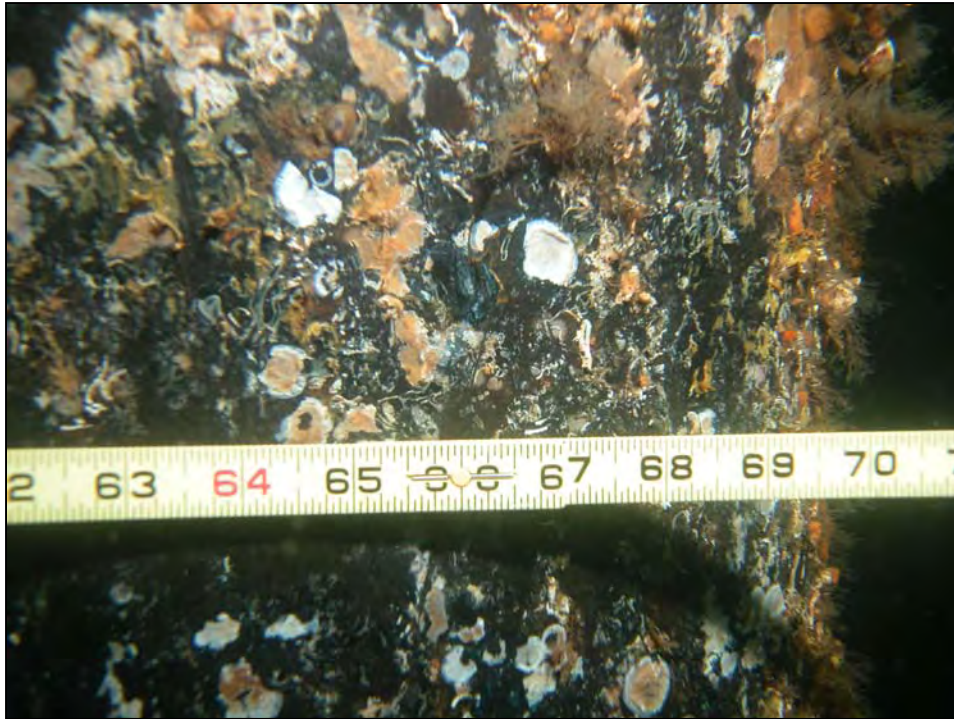


Photo No. 31: Typical marine growth below water. (Photo by Childs Engineering Corp.)

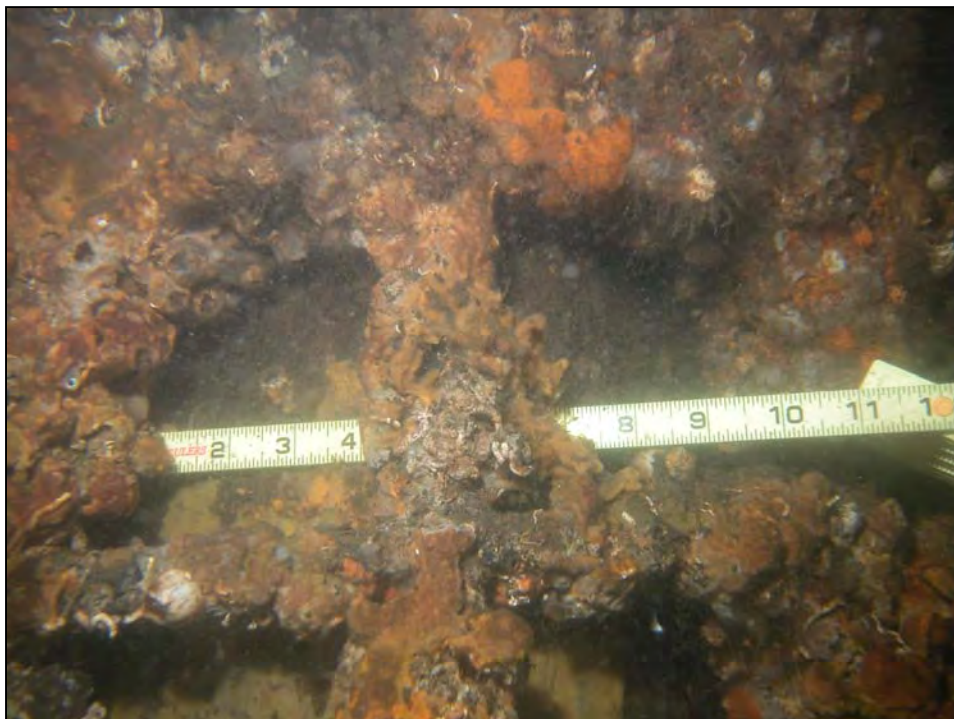


Photo No. 32: Underwater photo of exposed reinforcement. (Photo by Childs Engineering Corp.)



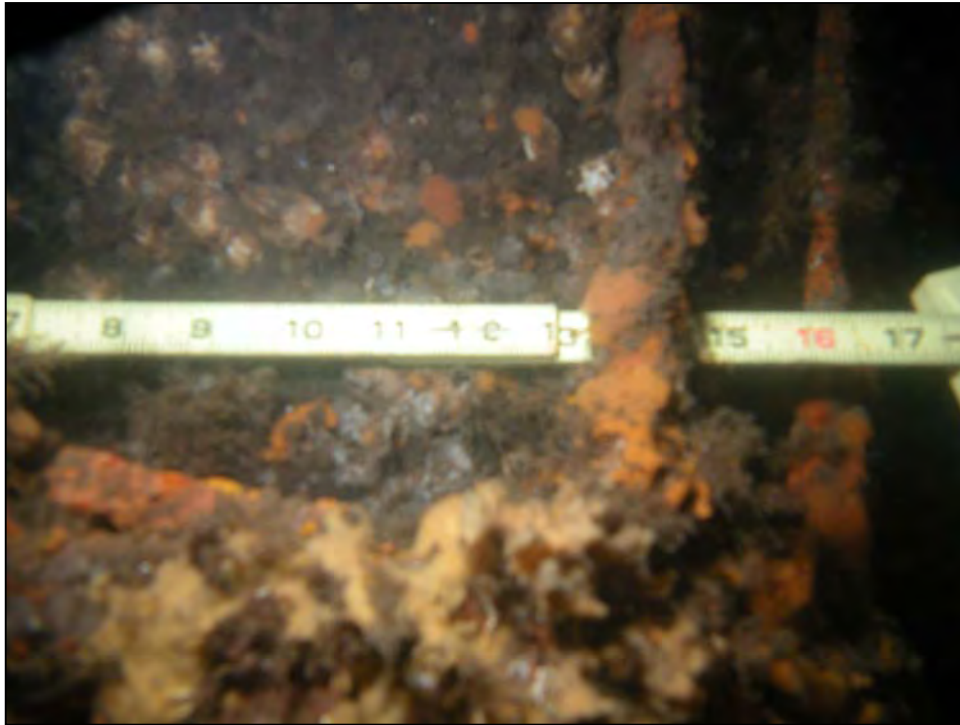


Photo No. 33: Typical view of the exposed steel reinforcement cage at the location of the missing concrete pile jacket. (Photo by Childs Engineering Corp.)



Photo No. 34: Underwater photo of marine growth on the pile. (Photo by Childs Engineering Corp.)



***Appendix B***  
***Key Personnel***  
*Steamship Pier*  
*New Bedford, Massachusetts*

## KEY PERSONNEL

*The following personnel were involved with this project including but not limited to the topside and underwater inspections and the preparation of this report:*

<b><i>Name</i></b>	<b><i>Employer</i></b>	<b><i>Responsibilities</i></b>
<i>Karl Hammond, P.E.</i>	<i>PARE Corporation</i>	<i>Project Manager, Lead Engineer</i>
<i>Ernest O. Rabideau, Jr., P.E.</i>	<i>PARE Corporation</i>	<i>Project Reviewer</i>
<i>Matt Bellisle, P.E.</i>	<i>PARE Corporation</i>	<i>Principal in Charge</i>
<i>Craig Sams, P.E.</i>	<i>Childs Engineering Corporation</i>	<i>Principal in Charge</i>
<i>Robert Garrity, P.E.</i>	<i>Childs Engineering Corporation</i>	<i>Project Engineer for Underwater Inspections</i>
<i>Kevin Champagne, P.E.</i>	<i>PARE Corporation</i>	<i>Support Engineer</i>
<i>Richard Fitzgerald, P.E.</i>	<i>Childs Engineering Corporation</i>	<i>Underwater Inspection Team</i>
<i>Charlie Marshall Roberts</i>	<i>Childs Engineering Corporation</i>	<i>Underwater Inspection Team</i>
<i>Robert Welch</i>	<i>Childs Engineering Corporation</i>	<i>Underwater Inspection Team</i>
<i>Phil Iantosca</i>	<i>Childs Engineering Corporation</i>	<i>Underwater Inspection Team</i>
<i>Nicholas B. Sarata</i>	<i>Childs Engineering Corporation</i>	<i>Underwater Inspection Team</i>
<i>Ryan McCoy</i>	<i>PARE Corporation</i>	<i>Topside Inspection</i>
<i>Briscoe B. Lang</i>	<i>PARE Corporation</i>	<i>Permitting Services</i>



*Appendix C*  
*Backup Data for Cost Estimates*  
*Steamship Pier*  
*New Bedford, Massachusetts*

**STEAMSHIP PIER**  
**OPINION OF PROBABLE CONSTRUCTION COST**  
February, 2009

<b>PIER REHABILITATION</b>				
	QTY	UNIT	UNIT PRICE	TOTAL

**High Priority Repairs**

1. Mobilization/Demobilization	1	LS	\$ 10,000.00	\$ 10,000.00
2. Demolition and Removal	1	LS	\$ 8,000.00	\$ 8,000.00
3. Pile Encasement	104	EACH	\$ 2,500.00	\$ 260,000.00
4. Reattachment of Cross Bracing	1	LS	\$ 30,000.00	\$ 30,000.00
5. Fender System Repairs	1	LS	\$ 150,000.00	\$ 150,000.00
6. Concrete Deck Repairs	1	LS	\$ 25,000.00	\$ 25,000.00

	Subtotal	\$	483,000.00
	Contingency 20%	\$	96,600.00
	<b>Total Alt.1</b>	<b>\$</b>	<b>579,600.00</b>

**Low Priority Repairs**

1. Mobilization/Demobilization	1	LS	\$ 10,000.00	\$ 10,000.00
2. Demolition and Removal	1	LS	\$ 4,000.00	\$ 4,000.00
3. Install Cathodic Protection	6,150	LB	\$ 12.00	\$ 73,800.00

	Subtotal	\$	87,800.00
	Contingency 20%	\$	17,560.00
	<b>Total Alt.2</b>	<b>\$</b>	<b>105,360.00</b>



*Appendix D*  
*References*  
*Steamship Pier*  
*New Bedford, Massachusetts*

## REFERENCES

The following references were utilized during the preparation of this report and the development of the recommendations presented herein:

1. *“About the Port – Key Locations”*, New Bedford Harbor Development Commission, <http://www.newbedford-ma.gov/PortofNewBedford/AboutPort/KeyLocations.html>
2. *Construction Drawings “Proposed Repairs and Improvements to Wharves and Piers in New Bedford and Fairhaven, MA”*, Tibbetts Engineering Corp., January 23, 1998 (Revised March 20, 1998).
3. *Construction Drawings “Extension of Steamship Pier”*, Tibbetts Engineering Corp., March 1986.





*Appendix E*  
*Field Notes*  
*Steamship Pier*  
*New Bedford, Massachusetts*

①

NEW BEDFORD WATERFRONT

FACILITIES INSPECTIONS

Nov. 14, 08

55° F SHOWERS / OVERCAST

STEAMSHIP PIER

STA 0400 - CORNER TIMBER DECK

STA 0400 - 0412 - STEEL 6' HIGH SECURITY FENCE

STA 0400 - 0408 - 5' DECK EXTENSION

STA 0411.5 - PILE BENT

\* BOLTS SPANED 9' O.C. (TYP.)

\* PILE CAPS EXTEND 12" WATERSIDE OF DECK FACE

STA 0435 - 10" CLEAT

STA 0436.5 - END OF PILE CAP DESTROYED

STA 0442 - 40" WIDE SIGN

STA 0448 - CLEAT

STA 0470 - POWER BOX ON DECK FACE

- PVC RAILWAY FROM STA 0400 - 0470

STA 0478 - STEEL LADDER - 16.5" CLEAR

- GOOD CONDITION & ATTACHED w/

CHAIN - NEEDS RE-BOLTING

STA 0484 - 40" WIDE SIGN

STA 0494 - CLEAT (BOLTS BENT)

\* 12" X12" TIMBER CUBES GOOD - FAIR (MINOR WEAR & ROT)

②

WATER DEPTHS TO THE TOP OF DUCK			
11'	⊙	STA 0425	
11'	⊙	STA 0450	
11'	⊙	STA 0475	
13.5'	⊙	STA 1400	
17'	⊙	STA 1475	
18'	⊙	STA 1450	
16.5'	⊙	STA 1475	
16.5'	⊙	STA 2400	
17.5'	⊙	STA 2425	
19'	⊙	STA 2450	
19'	⊙	STA 2475	
17'	⊙	STA 3400	
17'	⊙	STA 3425	
16.5'	⊙	STA 3475	
21.5'	⊙	STA 4400	
21.5'	⊙	STA 4425	
24'	⊙	STA 5400	
26'	⊙	STA 5450	
26'	⊙	STA 6425	
24.5'	⊙	STA 6450	
23'	⊙	STA 7425	

③

STA 1+08.5 - CURB (LOOSE - BROKEN TIMBER)

JA 1+14 - 40" WIDE SIGN

STA 1+17, 1+26, 1+44 - END OF

PILE CAP DAMAGED

STA 1+24 - 1+54 - TIMBER CURB DAMAGED AND DISPLACED (ROTATED)

STA 1+54 - CORNER OF TIMBER DICK

\* 1" X 6" TIMBER DECKING IN FAIR CONDITION

- MILD GROWTH, SOME SPLINTERING AND WARPING, SOLID - NO LOOSE BOARDS/BUNDS

→ FENDER SYSTEM ALONG PILE SUPPORT PILE:

- 10" TIMBER PILES 8' O.C.

- 8" X 8" TIMBER CHOCKS w/ 1" L X 4" X 8" SPACERS

- 2" X 12" CAP

- 8" X 12" SPACER (CONTINUOUS)

→ 12" H X 16" W CONCRETE CURB

- 3" X 3" L ON CORNERS

STA 1+55 - ELECTRICAL RECESSWAY ON TOP OF CURB - RUNS UNDER WATER AND ALONG LANDSIDE FACE OF CURB

④

WATER DEPTHS TO TOP OF PILE

24' (2) STA 8+00

24' (2) STA 8+25

23' STA 8+50

22' STA 9+00

22.5' STA 9+50

22.5' STA 10+00

24' STA 10+50

24.5' STA 11+00

23.5' STA 11+50

24' STA 12+00

21' STA 12+50

17' STA 13+00

17' STA 13+50

16' STA 14+00

14.5' STA 14+50

12' STA 15+00

13' STA 15+40





STA 2+87 - 2+95 - BROKEN/MISSING CHOICE

STA 3+03 - 3+11 - BROKEN/MISSING CHOICE

STA 3+11 - CLEAT (DAMAGED TIMBER @ BOLTS) RUBBER

STA 3+16 - EXPANSION JOINT / END OF MISSING TIMBER CAP

STA 3+20 - RUBBER ATTACHED

STA 3+25 - EJECT. OUTLET ON CURBFACE

STA 3+35 - 10"X10" UTILITY ACCESS ON TOP OF CURB

STA 3+36 - CLEAT

STA 3+37 - COGNIE - DAMAGED / MISSING TIMBER CAP

STA 3+49 - CHOICE WORN (FAIR TO POOR)

STA 3+60 - CLEAT

STA 3+68 - MISSING FENDER PILE  
 → SPACE IN CHOCKS / BOLT IN PLACE  
 → BROKEN CHOCKS BOTH SIDES

STA 3+84 - CLEAT

STA 4+00 - PILE

INSPECTION NOTES

CONCRETE DECK

- LONGITUDINAL CRACKS ± 48' O.C. (TYP., MAIN PIER)

- TRANSVERSE CRACKS ± 25' O.C. (TYP., MAIN PIER)

- (2) EXPANSION JOINTS ALONG MAIN PIER - FILLER IN POOR CONDITION (DRY, SOME MISSING, LOOSE SOIL & GRASS GROWTH IN JOINT (TYP.))

- EXPANSION JOINTS 25' O.C. (TYP., PIER EXTENSION)

- JOINT FILLER MISSING, DRY, LOOSE JOINTS FILLED w/ GRAVEL/SOIL/ASPHALT (TYP.)

- STA 4+36 - 4+61 - LONG. CRACK

STA 4400 - CLEAT  
 STA 4410 - CORNER OF WALL  
 STA 4412 - CLEAT

\* CAP MISSING FROM CONCRETE CURB @ STA 4436

STA 4417-4425 - SLOTTED / MISSING CHOCK  
 STA 4420 - UNDERLIE MUTILATED TO CHOCK HANGING w/ 1 BOLT

STA 4432 - LIFE RING  
 STA 4436 - CORNER OF CURB  
 STA 4438 - CLEAT / LIGHT POLE  
 STA 4444.5 - 10" UTILITY ACCESS IN TOP OF CURB

STA 4454 - 4462 - MISSING CAP  
 STA 4462 - CLEAT  
 STA 4480.5 - CLEAT  
 STA 4494 - FIRE ON TIMBER

BURNED HOLE IN CAP / SIGNIFICANT PILE LOSS @ TOP OF FLUNDER PILE  
 STA 4498.5 - UNDERLIE

- STA 4445 - 24" x 10" SPALL @ CL OF PIER

- STA 4461 - EXPANSION JOINT / 48" WIDE ASPHALT PATCH (FORMER SPALL w/ EXPOSED REINF)

- STA 4486 - EXPANSION JOINT / 36" WIDE ASPHALT PATCH (FORMER SPALL w/ EXPOSED REINF.) SPALL EXTENDING ± 6" BEYOND PATCH IN SEVERAL LOCATIONS

- STA 4486 - S+11 - (4) LONGITUDINAL CRACKS w/ EXPOSED REINF

- STA S+11 - EXPANSION JOINT w/ ASPHALT PATCH

- STA S+36 - EXPANSION JOINT w/ ASPHALT PATCH

STA 5+100 - ASPHALT PATCH ± 10' RIGHT OF C.L.

STA 5+134 - CURB

STA 5+158 - ASPHALT PATCH ± 10' RIGHT OF C.L.

STA 5+172 - CURB FACE (NO EXPOSED REIN)

STA 5+188 - EXPANSION JOINT W/ ASPHALT PATCH FROM CL TO RIGHT CURB / SPALL W/ ± 4" WIDE LEFT OF CL

STA 5+212 - EXPANSION JOINT W/ MINIMAL ASPHALT PATCHING

STA 5+236 - EXPANSION JOINT W/ 16" Ø SPALL W/ EXPOSED REIN ± 10' LEFT OF C.L.

STA 5+270 - EXPANSION JOINT W/ 16" X 24" SPALL W/ EXPOSED REIN. ± 8' RIGHT OF CL

STA 5+304 - EXPANSION JOINT W/ 16" Ø SPALL W/ ASPHALT PATCH AND EXPOSED REIN

STA 5+338 - TIRE ON FACE

STA 5+372 - TIRE ON FACE

STA 5+406 - TIRE ON FACE

STA 5+440 - TIRE ON FACE

STA 5+474 - TIRE ON FACE

STA 5+508 - TIRE ON FACE

STA 5+542 - TIRE ON FACE

STA 5+576 - TIRE ON FACE

STA 5+610 - TIRE ON FACE

STA 5+644 - TIRE ON FACE

STA 5+678 - TIRE ON FACE

STA 5+712 - TIRE ON FACE

STA 5+746 - TIRE ON FACE

STA 5+780 - TIRE ON FACE

STA 5+150 - 5' x 5' - 54" WIDE ASPHALT PATCH ± 10' RIGHT OF C.L.

STA 5+172 - 5' x 5' - SPALLING OF CURB FACE (NO EXPOSED REIN)

STA 5+188 - EXPANSION JOINT W/ ASPHALT PATCH FROM CL TO RIGHT CURB / SPALL W/ ± 4" WIDE LEFT OF CL

STA 5+212 - EXPANSION JOINT W/ MINIMAL ASPHALT PATCHING

STA 5+236 - EXPANSION JOINT W/ 16" Ø SPALL W/ EXPOSED REIN ± 10' LEFT OF C.L.

STA 5+270 - EXPANSION JOINT W/ 16" X 24" SPALL W/ EXPOSED REIN. ± 8' RIGHT OF CL

STA 5+304 - EXPANSION JOINT W/ 16" Ø SPALL W/ ASPHALT PATCH AND EXPOSED REIN

STA 5+338 - TIRE ON FACE

STA 5+372 - TIRE ON FACE

STA 5+406 - TIRE ON FACE

STA 5+440 - TIRE ON FACE

STA 5+474 - TIRE ON FACE

STA 5+508 - TIRE ON FACE

STA 5+542 - TIRE ON FACE

STA 5+576 - TIRE ON FACE

STA 5+610 - TIRE ON FACE

STA 5+644 - TIRE ON FACE

STA 5+678 - TIRE ON FACE

STA 5+712 - TIRE ON FACE

STA 5+746 - TIRE ON FACE

STA 5+780 - TIRE ON FACE

STA 5+814 - TIRE ON FACE

STA 5+848 - TIRE ON FACE

- STA 6+78 - CLEFT / TIRE ON FACE
- STA 6+83 - LOCAL WOODPILE ON 8" X 12" CONTINUOUS SPACER
- STA 7+02 - CLEFT / TIRE ON FACE
- STA 7+14 - LADDER (POPE-BUCKLED)
- STA 7+26 - CLEFT
- STA 7+26-7+34 - LOOSE CAP BOARD
- STA 7+50 - CLEFT / MISSING CAP
- STA 7+74 - CLEFT / MISSING CAP
- STA 7+86 - LADDER (POPE-BUCKLED)
- STA 7+92 - 10'  $\phi$  UTILITY BOX ON CAR / MISSING CAP
- STA 7+98 - LIGHT POLE
- CLEFT
- MISSING CAP
- STA 8+03 - BROKEN CHECK
- STA 8+06 - BROKEN PILE
- STA 8+21 - LIFE RING
- STA 8+23 - CORNER OF PILE
- 7 TIMBER PILE CLUSTER
- STA 8+24 - CLEFT / BROKEN CHECK (MISSING)
- STA 8+28 - APPARENT FIRE ON CAR / SPACER / CHECK

- STA 6+08 - EXPANSION JOINT w/ MINIMAL ASPHALT PATCHING
- STA 6+30 - EXPANSION JOINT w/ RUBBER FLOOR INTACT
- STA 6+22 - 16" X 4" SPALL w/ NO EXPOSED REINF
- STA 6+55 - EXPANSION JOINT w/ MINIMAL ASPHALT PATCHING. SOME SPALLING 2"-4" WIDE, NO EXPOSED REINF
- STA 6+76 - 12"  $\phi$  SPALL w/ EXPOSED REINF
- STA 6+78 - EXPANSION JOINT w/ SOME ASPHALT PATCHING / SOME MINOR SPALLS ( $\pm 3"$   $\phi$ ) w/ NO EXPOSED REINF
- STA 7+03 - EXPANSION JOINT w/ ASPHALT PATCHING / SPALLING



(15)

STA 8+36 - MISSING CHOCK / BROKEN,  
8X12 SPACE

STA 8+41 - 8+49 - MISSING CHOCKS  
AND SPACERS AND 8X12 SPACE

STA 8+53 - LADDER (POOR - BUCKLED)

STA 8+60 - (ORNER - MISSING CAP

STA 8+65 - CLEAT (WOOD DAMAGE AT  
ISOLS) TIRE ON FRONT

STA 8+81 - CORNER OF PICK

- CLEAT (BOTH FACES)

- CORNER FENDER PILLS IN

POOR CONDITION (WORN)

STA 9+09 - CLEAT / ANCHOR BOLTS ↓

WIRES FOR LIGHT POLE

STA 9+13 - 10" Ø UTILITY ACCESS COVER

STA 9+19 - LADDER (POOR - BUCKLED)

STA 9+21 - CLEAT / LIFE RING

STA 9+54 - CLEAT

STA 9+56 - CORNER OF PICK

STA 9+76 - FENDER PILE BROKEN NEAR MHW

@ LOW WALE

- CHOCKS MISSING TO CORNER

- DISPLACED 8X12 SPACE

(16)

- STA 7+28 - EXPANSION JOINT w/  
SOME ASPHALT PATCHING / SEVERAL  
SPALLS UP TO 24" X 4" W X 2" D

- STA 7+50 - EXPANSION JOINT w/  
ASPHALT PATCHING WATER SIDE OF  
JOINT / CRACKING AND SPALLING  
LANDSIDE OF JOINT

→ (2) 12" Ø SPALLS w/ NO  
EXPOSED REIN ± 10' FROM  
RIGHT CURB

\* LONGITUDINAL EXPANSION JOINT FROM  
STA 7+50 TO 7+98

- ASPHALT PATCH LEFT 4' RIGHT OF  
LONG. EX. JOINT w/ SPALLING  
AROUND PATCH

- STA 7+74 - EXPANSION JOINT w/  
ASPHALT PATCHING / 12" Ø SPALL  
w/ NO EXPOSED REIN ± 18'  
FROM LEFT CURB / 48" X 36"  
SPALL w/ NO EXPOSED REIN ±  
RIGHT OF LONG. EX. JOINT

- STA 9+87 - CLEAT
- STA 9+89 - CORNER OF PIER
- STA 9+96 - BROKEN CHOCK
- STA 10+00 - LADDER (POOR BUCKLED)
- STA 10+12 - LIGHT POST / CLEAT
- STA 10+18 - UTILITY ACCESS 10"  $\phi$  / DAMAGED CAP ?
- STA 10+36 - CLEAT / LOOSE CAP
- STA 10+41 - MISSING CAP TO 11+00
- STA 10+60 - CLEAT / WORN PILE / MISSING CHOKES TO 10+68
- STA 10+72 - LADDER (FAK TO POOR - BUCKLED)
- STA 10+82 - CLEAT
- STA 10+84 - EXPANSION JOINT
- STA 11+09 - CLEAT
- STA 11+14 - 10"  $\phi$  UTILITY ACCESS BOX / MISSING CAP
- STA 11+33 - CLEAT / OL LOOSE CAP
- STA 11+38 - MISSING CAP
- STA 11+41 - MISSING CHOCK
- STA 11+45 - LADDER (POOR - BUCKLED)
- MISSING CHOCK
- STA 11+54 - MISSING CAP

- STA 7+98 - EXPANSION JOINT w/ ASPHALT PATCHING / SPALLS EXTENDING BEYOND PATCH LIMITS 3'-6" TYP
- STA 8+53 - LONGITUDINAL CRACK EXTENDING UNWISIDE TO STA 7+98 @ EXPANSION JOINT
- STA 7+86 - 12" WIDE SPALL @ LEFT EDGE OF DECK w/ DAMAGED REINFC
- STA 7+38 - SPALLING @ LEFT EDGE OF DECK
- STA 7+10 - 8" SPALL @ LEFT EDD
- STA 6+56 - 6' GA - SPALLING @ LEFT EDD & FACE OF DECK w/ EXPOSED REINFC

- STA 11+55 - LIFE RINK
- STA 11+57 - CLIENT
- STA 11+65 - 8X12 SPACER BROKEN AT  
FENDER PILE LOCATION
- STA 11+73 - 8X12 SPACER BROKEN AT  
FENDER PILE LOCATION
- STA 11+81 - CLEAR
- STA 11+87 - CRACKED / LOOSE CAP
- STA 12+05 - LIGHT POLE / CLEAR
- STA 12+11 - 10"  $\phi$  UTIL. ACCESS BOX
- STA 12+17 - LADDER (POOR-BUCKLED)
- STA 12+23 - DAMAGED CAP
- STA 12+29 - CLEAR
- STA 12+41 - WOODEN CHOCK
- STA 12+46 - CL LOOSE CAP
- STA 12+53 - CLEAR
- STA 12+58 - LOOSE CAP BOARDS (INTERSECTION)
- STA 12+66 - MISSING CAP
- STA 12+71 - 10"  $\phi$  UTIL. BOX
- STA 12+77 - CLIENT
- STA 12+80 - EXPANSION JOINT

\* OLD / NEW PIER INTERSECTION

- UNDER DECK INSPECTION
- 16X45X $\frac{3}{4}$  DOUBLE CHANNEL  
W/AL - POOR CONDITION  
SUPPORTING PILECAPS
  - PILECAPS - CRACKED - GOOD CONDITION
  - STRAINERS - CAP SPLICES  
CRACKS - GOOD CONDITION









**CHILDS ENGINEERING CORPORATION**

**PRE-DIVE MEETING & EQUIPMENT SAFETY CHECKLIST**

**Pre-Dive Meeting**

CEC Project #: New Bedford Date: 11/14/08  
 Supervisor: RFG Crew: RJW, PDI, RFG, NS, RY

Dive Mode:  SSA  SCUBA  Wading  
 Dive Plan Prepared:  YES  NO  
 Objective of Dive: \_\_\_\_\_  
 Thermal Protection:  Wet Suit  Dry Suit Water Temperature: 50.5°

Team Assignments		Diver Repet Group @ Start
Supervisor <u>RFG</u>	Diver 1 <u>PDI</u>	<u>2500</u>
Tender <u>RY</u>	Diver 2 <u>BW</u>	<u>2300</u>
Tender <u>NS</u>	Standby Diver	

Assessment of Team Members  Physically Fit  Ready to Dive  
 Emergency Procedures  Emergency Diver Bailout Bottle 2300 psi  
 Emergency Action Plan  Emergency Diver \_\_\_\_\_  
 Emergency Numbers Available  
 Cell Phone/2-Way Radio Operational

**Hazards Review**

Water Current	Maximum Depth	
<input checked="" type="checkbox"/> <1 Knot	<input type="checkbox"/> <10'	<input type="checkbox"/> 40' to 50'
<input type="checkbox"/> 1 to 2 Knots	<input type="checkbox"/> 10' to 20'	<input type="checkbox"/> 50' to 60'
<input type="checkbox"/> 2 to 3 Knots	<input checked="" type="checkbox"/> 20' to 30'	<input type="checkbox"/> 60' to 70'
<input type="checkbox"/> >3 Knots	<input type="checkbox"/> 30' to 40'	<input type="checkbox"/>

Loss of Air  Weather  
 Visibility \_\_\_\_\_ ft  Loss of Communication  
 Entrapment/Entanglement  Underwater Debris  
 Break Away from Moored Station  
 Ships at Berth  
 Suctions  Props  Rudder  
 Sonar  Underway  
 Tagout Notes: \_\_\_\_\_  
 Other: \_\_\_\_\_

Dive Team Attendees (Sign and Date)

1 <u>RFG</u>	<u>11/14/08</u>	4 <u>[Signature]</u>	<u>11/14/08</u>
2 <u>[Signature]</u>	<u>11/14/08</u>	5 <u>[Signature]</u>	<u>11/14/08</u>
3 <u>[Signature]</u>	<u>11/14/08</u>	6 _____	_____

**Pre-Dive Equipment Checklist**

**Surface Supplied Air (SSA)**  
 Fuel  Compressor Oil  Belts  Unloader  Filters  Engine Oil  Connections  
 Manifold Pressure \_\_\_\_\_ Psi  Volume Tank  
 Repairs or Corrections Made: \_\_\_\_\_

**Reserve Air Supply:**  
 HP Tank \_\_\_\_\_ PSI  Diver 1 Pony Tank 2500 PSI  Tanks Secure  
 HP Tank Regulated to \_\_\_\_\_ PSI  Diver 2 Pony Tank 2300 PSI  
 Standby Diver Pony Tank \_\_\_\_\_ PSI

**Umbilical's, Whips and Pressure Gauges:**  
 Connections Tight  Main Valves Open  Check for Manifold Leaks  Check For Cuts in Umbilical's  
 Blow Out Hoses  Bleed H2O Out Of Volume Tank  Non Return Valve  
 Repairs or Corrections Made: \_\_\_\_\_

**Dive Helmets:**  
 AGA Mask  Nose Pad  Swivel Connection  Bailout Block  
 Repairs or Corrections Made: \_\_\_\_\_

**SCUBA:**

Diver 1	Diver 2	Stand-by Diver	
Main Tank _____ PSI	Main Tank _____ PSI	Main Tank _____ PSI	<input type="checkbox"/> Pressure Gauge
Reserve Tank _____ PSI	Reserve Tank _____ PSI	Reserve Tank _____ PSI	<input type="checkbox"/> Depth Gauge
Standby Main Tank _____ PSI	Standby Reserve Tank _____ PSI	Standby Reserve Tank _____ PSI	<input type="checkbox"/> SCUBA Masks
Primary Regulators <input type="checkbox"/>	Primary Regulators <input type="checkbox"/>	Primary Regulators <input type="checkbox"/>	<input type="checkbox"/> Weight Belts
Backup Regulators <input type="checkbox"/>	Backup Regulators <input type="checkbox"/>	Backup Regulators <input type="checkbox"/>	<input type="checkbox"/> BCD
			<input type="checkbox"/> AGA Mask

**Communications:**  
 Diver Communication:  Batteries Charged / Changed  
 Repairs or Corrections Made: \_\_\_\_\_

**COMM SYSTEMS CHECK**  
 Surface Station  Test Diver 1  Test Diver 2

**General:**  
 Dive Logs  Navy Dive Tables  Navy Repetitive Dive Classifications  Dive Knife  
 Dive Flags Out  Ladder / Entry and Exit Points Secured  Dive Notes  Fire Extinguishers Charged  
 Repairs or Corrections Made: \_\_\_\_\_

Dive Supervisor: \_\_\_\_\_  
 Signature \_\_\_\_\_ Date \_\_\_\_\_



Pre-Dive Meeting

CEC Project #: Nova (Hammers Wharf)

Date: 11/19/09

Supervisor: PDI

Crew: PDI, RFG, NBS, RPY

Dive Mode:  SSA  SCUBA  Wading  
Dive Plan Prepared:  YES  NO

Objective of Dive:

Thermal Protection:

Wet Suit  Dry Suit Water Temperature 50<sup>+</sup>°F

Team Assignments

Supervisor <u>PDI</u>	Diver 1	Diver Repet Group @ Start
Tender <u>NBS</u>	Diver 2	
Tender <u>RPY</u>	Standby Diver <u>RPY</u>	

- Assessment of Team Members
- Physically Fit
- Ready to Dive
- Emergency Procedures
- Emergency Diver Bailout Bottle 2400 psi
- Emergency Action Plan
- Emergency Diver 2100
- Emergency Numbers Available 911
- Cell Phone/2-Way Radio Operational

Hazards Review

Water Current	Maximum Depth	
<input checked="" type="checkbox"/> <1 Knot	<input type="checkbox"/> <10'	<input type="checkbox"/> 40' to 50'
<input type="checkbox"/> 1 to 2 Knots	<input type="checkbox"/> 10' to 20'	<input type="checkbox"/> 50' to 60'
<input type="checkbox"/> 2 to 3 Knots	<input type="checkbox"/> 20' to 30'	<input type="checkbox"/> 60' to 70'
<input type="checkbox"/> >3 Knots	<input type="checkbox"/> 30' to 40'	<input type="checkbox"/>
<input checked="" type="checkbox"/> Loss of Air	<input checked="" type="checkbox"/> Weather	
<input checked="" type="checkbox"/> Visibility <u>8</u> ft	<input checked="" type="checkbox"/> Loss of Communication	
<input type="checkbox"/> Entrapment/Entanglement	<input checked="" type="checkbox"/> Underwater Debris	
<input type="checkbox"/> Break Away from Moored Station		
<input checked="" type="checkbox"/> Ships at Berth		
<input type="checkbox"/> Suctions	<input checked="" type="checkbox"/> Props	<input type="checkbox"/> Rudder
<input type="checkbox"/> Sonar	<input type="checkbox"/> Underway	
<input type="checkbox"/> Tagout	Notes:	
<input type="checkbox"/> Other:		

Dive Team Attendees (Sign and Date)

1 <u>[Signature]</u>	<u>11/18/08</u>	Date	4 _____	Date
2 <u>[Signature]</u>	<u>11/18/08</u>	Date	5 _____	Date
3 <u>[Signature]</u>	<u>11/18/08</u>	Date	6 _____	Date

Pre-Dive Equipment Checklist

- Surface Supplied Air (SSA)  Fuel  Compressor Oil  Belts  Unloader  Filters  Engine Oil  Connections
- Manifold Pressure 120 Psi  Volume Tank
- Repairs or Corrections Made: N/A

Reserve Air Supply:

- HP Tank \_\_\_\_\_ PSI
- HP Tank Regulated to \_\_\_\_\_ PSI
- Diver 1 Pony Tank \_\_\_\_\_ PSI
- Diver 2 Pony Tank \_\_\_\_\_ PSI
- Standby Diver Pony Tank \_\_\_\_\_ PSI
- Tanks Secure

Umbilical's, Whips and Pressure Gauges:

- Connections Tight
  - Main Valves Open
  - Check for Manifold Leaks
  - Check For Cuts in Umbilical's
  - Blow Out Hoses
  - Bleed H2O Out Of Volume Tank
  - Non Return Valve
- Repairs or Corrections Made: \_\_\_\_\_

Dive Helmets:

- AGA Mask
  - Nose Pad
  - Swivel Connection
  - Bailout Block
- Repairs or Corrections Made: \_\_\_\_\_

SCUBA:

Diver 1	Diver 2	Stand-by Diver	
Main Tank _____ PSI	Main Tank _____ PSI	Main Tank _____ PSI	<input type="checkbox"/> Pressure Gauge
Reserve Tank _____ PSI	Reserve Tank _____ PSI	Reserve Tank _____ PSI	<input type="checkbox"/> Depth Gauge
Standby Main Tank _____ PSI	Standby Reserve Tank _____ PSI	Standby Reserve Tank _____ PSI	<input type="checkbox"/> SCUBA Masks
Primary Regulators <input type="checkbox"/>	Primary Regulators <input type="checkbox"/>	Primary Regulators <input type="checkbox"/>	<input type="checkbox"/> Weight Belts
Backup Regulators <input type="checkbox"/>	Backup Regulators <input type="checkbox"/>	Backup Regulators <input type="checkbox"/>	<input type="checkbox"/> BCD
			<input type="checkbox"/> AGA Mask

Communications:

- Batteries Charged / Changed
- Surface Station
- Test Diver 1
- Test Diver 2

Repairs or Corrections Made: \_\_\_\_\_

General:

- Dive Logs
- Navy Dive Tables
- Navy Repetitive Dive Classifications
- Dive Knife
- Dive Flags Out
- Ladder / Entry and Exit Points Secured
- Dive Notes
- Fire Extinguishers Charged

Repairs or Corrections Made: \_\_\_\_\_

Dive Supervisor:

[Signature] 11/19/09  
Signature Date



CHILDS ENGINEERING CORPORATION

Waterfront and Structural Engineering

BOX 333, MEDFIELD, MA 02052


JOB Divers. B&W R PDI 10:150 DIVERS IN

SHEET NO. OF 12:30 Divers OUT

CALCULATED BY DATE

CHECKED BY DATE

SCALE

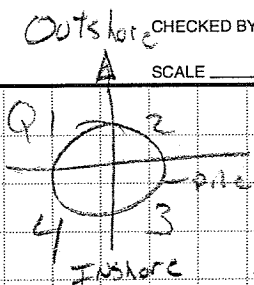

Steamship Pier

New Extension

South Side P1 →

Fender Pile Good

Best 13 - Pile 1

Surface Rust

60% COATING REMAINING Pitting 1/16"

MLW

.375 Q1  
.365 Q2  
.375 Q3  
.370 Q4

MID

MID

.370 Q1  
.370 Q2  
.365 Q3  
.365 Q4

MUD

.360 Q1  
.330 Q2  
.330 Q3  
.335 Q4

Potential Repair

.430 V  
.175 V

Potential Repair

.488 V  
.500 V

Potential Repair

.490 V

Steel good smoother 90% coating

Pitting 1/16"

Best 12

- Fender piles good, sound, no MB.

Best 11

Pile 1

MLW

.370 Q1  
.370 Q2  
.370 Q3  
.360 Q4

Potential Repair  
.516 V

MID

.370 Q1  
.390 Q2  
.360 Q3  
.370 Q4

Potential Repair  
.502 V

MUD

.320 Q1  
.325 Q2  
.330 Q3  
.380 Q4

TYPICAL Top 3' 50% COATING Lost  
CONDITIONS mid 100% COATING REMAINING  
MUD 100% COATING Lost - small 1/16" PITS

Best 13

Groove Patch - 3" Deep - Failed Repair

OUTSHORE SIDE 3SF MAX DEPT 3" NO REPAIR EXPOSED BETWEEN P6 - P7 ON CAP

Best 14

L2 @ P9

- top. steel 60% COATING INTACT 1/16" Pitting @ all QUADS  
mid 80% COATING INTACT - 1/16" Pitting  
MUD 80% INTACT 1/16" Pitting

P7 1' North 4sf small ON concrete CAP





**CHILDS ENGINEERING CORPORATION**

Waterfront and Structural Engineering

BOX 333, MEDFIELD, MA 02052

JOB Steamship Pier Extension


SHEET NO. \_\_\_\_\_ OF \_\_\_\_\_

CALCULATED BY RFB DATE 11/14/03

CHECKED BY \_\_\_\_\_ DATE \_\_\_\_\_

SCALE \_\_\_\_\_

**BEAM BETWEEN**

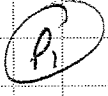

13 & 14  
Outshore Pile

MLW


.370	Q1
.370	Q2
.365	Q3
.365	Q4

MID

.370	Q1
.355	Q2
.360	Q3
.365	Q4

MUD

.305	Q1
.320	Q2
.340	Q3
.325	Q4

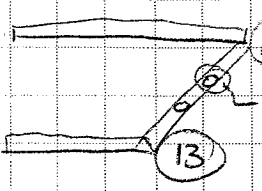

Potential  
.449

Potential  
.448

Potential  
.458

P6 - P4 - Spall 3" Deep Top & Outer Edge of Pile cap  
Batter Pile 2 - 3 - Spall 4 SF

Fender Pile @ Beam 14 is Broken @ Low Water Whale - Whale's Broken Between  
B14 & 15

**BEAM 16**



16" φ  
Steel Pipe  
Piles

ML

.370	Q1
.370	Q2
.370	Q3
.370	Q4

Potential  
.454

MID

.370	Q1
.360	Q2
.350	Q3
.360	Q4

Potential  
.445

MUD

.320	Q1
.330	Q2
.325	Q3
.320	Q4

Potential  
.446

**BEAM 15 -**

Corner crack / spall 3 SF SW Deep outshore on Pile cap  
@ Pile 5

Pile cap 1' towards 6 from 7 4 SF & spall 3" Deep outshore face of  
CAP

Between 9 & 10 - Spall 3" Deep 5 SF  
ON CAP

Piles typical condition 80% coating loss - small pitting 1/16"

Fender Pile Between BEAM 15 & 16 Split Above Low Water whale pile cracks this  
location



CHILDS ENGINEERING CORPORATION

Waterfront and Structural Engineering

BOX 333, MEDFIELD, MA 02052

JOB \_\_\_\_\_

SHEET NO. \_\_\_\_\_ OF \_\_\_\_\_

CALCULATED BY \_\_\_\_\_ DATE \_\_\_\_\_

CHECKED BY \_\_\_\_\_ DATE \_\_\_\_\_

SCALE \_\_\_\_\_

Fender Pile Between 16 & 17 Broken @ White @ L2 Broken & Pushed in - 2 Piles up from Bent 16 towards Pier

**Bent 16** Pile 3 L2 @ MID 1/16" Pitting COATING 40% REMAINS

**Bent 17** Fender Piles OK - ABRASION ON CORNERS typical CONDITIONS FOR PILES


**Bent 10** L2 - P4 SURFACE RUST, SMALL PITS COATING 40% INTACT.

MID 80% - 90% INTACT - @ 2 1/2" WIDE 1/2" DEEP PIT  
Bottom 40% COATING REMAINS VTS - 8-10'

\* General Note - CONCRETE UNDERDECK LOOKS pretty GOOD <sup>Typical</sup>

P7 - top 3-foot coating is Blistering off

Bent 10 - fender pile on North side 1/4 of DAM. ABRADED off by BOATS

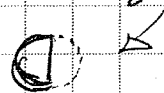

**Bent 9** Fender Piles Between 9 & 10 Both Broken @ Pilecap MHW MARK

Pile 1 Open Corrosion Spall Top outside side of Pilecap 5" DEEP - SSF



CHILDS ENGINEERING CORPORATION

Waterfront and Structural Engineering

BOX 333, MEDFIELD, MA 02052

JOB \_\_\_\_\_

SHEET NO. \_\_\_\_\_ OF \_\_\_\_\_

CALCULATED BY \_\_\_\_\_ DATE \_\_\_\_\_

CHECKED BY \_\_\_\_\_ DATE \_\_\_\_\_

SCALE \_\_\_\_\_

Bent 9

(P1)

MUD

.335 Q1

.380 Q2

.345 Q3

.365 Q4

Potential

.500

MID

.350 Q1

.370 Q2

.360 Q3

.370 Q4

Potential

.510

MUD

.325 Q1

.330 Q2

.315 Q3

.330 Q4

Potential

.511

70% COATING INTACT MID PILE

1/8" PITS OVER SURFACE COATING 20% REMAINS

PHOTO 476 Castone used

Bent 13 - Pile 1 PHOTOS

#488 - LAST PHOTO #1

Bent 8 L2-PS good 85-90% INTACT COATING

Steel mud 1/4" PITS 20-40% INTACT COATING

Bent 9 - Pile 7 Pile CAP SMALL OPEN CORROSION SPALL

REBAR CORRODED & CONCRETE SPALL

TOP TO BOTTOM OF CAP 108F

1 1/2 FT DEEP @ MAX UPTO 1/2" DEEP EDGES

3 BARS SHOWING

Bent 7

Bent 6 - Piles Look Wonderful



CHILDS ENGINEERING CORPORATION

Waterfront and Structural Engineering

BOX 333, MEDFIELD, MA 02052

JOB \_\_\_\_\_

SHEET NO. \_\_\_\_\_ OF \_\_\_\_\_

CALCULATED BY \_\_\_\_\_ DATE \_\_\_\_\_

CHECKED BY \_\_\_\_\_ DATE \_\_\_\_\_

SCALE \_\_\_\_\_

Bent 7 (P.7)

MLW  
.365 Q1  
.365 Q2  
.370 Q3  
.380 Q4

Potential  
.510  
Steel Smooth  
60% intact coating

MUD  
.370 Q1  
.375 Q2  
.375 Q3  
.380 Q4

Potential  
.508  
50% intact  
Corrosion 1/8" wide 1/8" deep  
Pits

MUD  
.345 Q1  
.345 Q2  
.360 Q3  
.365 Q4

Potential  
.508  
50-40% intact  
1/16" Pits  
All Quads

Bent 5 (P1)

MLW  
.380 Q1  
.390 Q2  
.370 Q3  
.380 Q4

85%-90% intact

MUD  
.365 Q1  
.385 Q2  
.380 Q3  
.375 Q4

Potential  
.514

MUD  
.335 Q1  
.340 Q2  
.345 Q3  
.330 Q4

Smooth steel coating  
40% intact  
Potential  
.513

Bent 4 RSW - Potential  
↳ LIT on P4  
.565

Bent 4 - Piles good & typical condition

From Bottom <sup>MUD</sup> 8' coating cone  
1/4" BLACK corrosion byproduct  
50% of coating From CAP to MUD  
100% coating Remaining @ MUD

PHOTOS

#477 - Bent 13 Pile #1 top clean

#480 Bent 13 Pile 1 Top Clean

#481 - MUD cleaning B13 P1

#483

#484 - MUD thru 488 mudline

#489 - 491. Attempt to get  
Pile cap Spall  
(impact?)





CHILDS ENGINEERING CORPORATION

Waterfront and Structural Engineering

BOX 333, MEDFIELD, MA 02052

Move station.

JOB \_\_\_\_\_ RSW  
 SHEET NO. DIVERS IN 2:30 OF PDI  
 CALCULATED BY CTC 4:10 DATE \_\_\_\_\_  
 CHECKED BY \_\_\_\_\_ DATE \_\_\_\_\_  
 SCALE \_\_\_\_\_

New extension

**Bent 3**

MLW	MID	MUD
.360 Q1	.365 Q1	.350 Q1
.360 Q2	.365 Q2	.315 Q2
.360 Q3	.365 Q3	.345 Q3
.365 Q4	.365 Q4	.345 Q4
Potential .351	Potential .324	Potential .352

COATING 90% INTACT Steel smooth  
 Steel mud 1/8" PITS 40% INTACT COATING

Piles OK Fenders OK

**Bent 2** LTH P3 -

COATING MLW & MID 80% COATING 1/16" PITS C  
 MUD 40% COATING

Fenders between 2 & 1 Broken #1 ABOVE lower  
 closer to 1 whole

**Bent 1**

MLW	MID	MUD
.375 Q1	.380 Q1	.310 Q1
.375 Q2	.375 Q2	.310 Q2
.375 Q3	.390 Q3	.300 Q3
.375 Q4	.380 Q4	.315 Q4
Potential .300	Potential .349	Potential .340

COATING 80% INTACT Steel smooth  
 80% INTACT Steel smooth  
 30-40% INTACT 1/16" PITS

5 Piles no Batteries



CHILDS ENGINEERING CORPORATION

Waterfront and Structural Engineering

BOX 333, MEDFIELD, MA 02052

JOB Steamship O/D

SHEET NO. \_\_\_\_\_ OF \_\_\_\_\_

CALCULATED BY \_\_\_\_\_ DATE \_\_\_\_\_

CHECKED BY \_\_\_\_\_ DATE \_\_\_\_\_

SCALE \_\_\_\_\_

Bent. 1

Bracing P1-5 Intact

- Hoop steel Exposed & Vert steel exposed to m  
Jacket goes down to 1' ABOVE MUD LINE  
Timber 10" x

Pile 2 - 4' Band @ MLW ReBAR exposed

P 3 - 4' Band centered @ X Brace 5' down  
From cap Exposed Rebar

P4 ~~same~~

P5 - 4' BAND exposed Hoop steel center @ MLW  
NO BRACING

P6 BRACING NOT ATTACHED - 4' BAND  
REBAR

P7 4' BAND Rebar Exposed

P8 6' BAND ReBAR Exposed

P9 OK



CHILDS ENGINEERING CORPORATION

Waterfront and Structural Engineering

BOX 333, MEDFIELD, MA 02052

JOB Steamship OD

SHEET NO. \_\_\_\_\_ OF \_\_\_\_\_

CALCULATED BY \_\_\_\_\_ DATE \_\_\_\_\_

CHECKED BY \_\_\_\_\_ DATE \_\_\_\_\_

SCALE \_\_\_\_\_

(B2)

Pile 7  $\rightarrow$   
Pile 6  $\rightarrow$  5' band no concrete left

Pile 7 Photos - 10-

Pile 5 & 4 Disintegration Aggregate Exposed 1/2" Deep  
Jacket to mud

Pile 3 - HW to LW - Rebar Exposed 2" Deep

Pile 2 3' Band @ LW Rebar Exposed 2" Deep

(B3)

P1 - 1/2" loss concrete MLW

P9 - ~~loss~~ loss section of Jacket 2" Deep  
Fender Pile outer - MB - 4"  $\phi$  mud up 4'  
 $\rightarrow$  Photos - 3 Piles

(B4)

P9 - Rebar exposed Photos -

P3 - Bracing NOT attached.

P2 - 2" loss 4' length -

P1 - exposed rebar 1" loss to 2" tidal zone



CHILDS ENGINEERING CORPORATION

Waterfront and Structural Engineering

BOX 333, MEDFIELD, MA 02052

JOB Steamship Old

SHEET NO. \_\_\_\_\_ OF \_\_\_\_\_

CALCULATED BY \_\_\_\_\_ DATE \_\_\_\_\_

CHECKED BY \_\_\_\_\_ DATE \_\_\_\_\_

SCALE \_\_\_\_\_

B7 P10 Bottom 3 ft Drawing notes 5"  
P4 & P5 Bracing Detached  
P1 & P10 Timber Exposed Below Tacket

B6 P1 & P9 Timber Exposed  
~~P10~~  
P10 - 10"  $\phi$   
Fender pile missing

9 piles total Piles 9, 8, 7, & 1 Exposed @ Bottom  
12"  
9 - 10"  $\phi$

Concrete Tacket @ 1 Pretty much gone  
3'-8' Below CAP REBAR LEFT

B5 - OK





CHILDS ENGINEERING CORPORATION

Waterfront and Structural Engineering

BOX 333, MEDFIELD, MA 02052



Old Port of Steamship Pier

JOB Old Port

SHEET NO. \_\_\_\_\_ OF \_\_\_\_\_

CALCULATED BY \_\_\_\_\_ DATE \_\_\_\_\_

CHECKED BY \_\_\_\_\_ DATE \_\_\_\_\_

SCALE Old Port STATE Pier

Bent 8

Pile 1 - Concrete Jacket  
 2' of timber exposed 14" diameter MB Evidence on outside of pile  
 Timber is solid

Concrete caps look good  
 Concrete Pile caps about 4' wide

Pile 2 1' of timber exposed 8"  $\phi$  1" Deep MB grooves

Pile 3 Jacket No mud

Pile 4 Bracing is disconnected

Pile 9 Concrete Jacket 4' Deep small 6' length through tidal zone exposed rebar

Bent 9 Pile 9 - Concrete Jacket disintegrated open to mud  
 Timber Pile exposed - 12" Hard

Pile 5 - Jacket 8" loss around permit Exposed rebar

Pile 1 2' exposed timber 9"  $\phi$  MB Evidence

Fender system looks good

Bent 10 P8 timber pile exposed 12"  $\phi$  mid tide to mud  
 7' Exposure

↳ 10 total piles

P6 } Bracing Detached  
 P5 }

Bent 11 10 piles



**CHILDS ENGINEERING CORPORATION**

Waterfront and Structural Engineering

BOX 333, MEDFIELD, MA 02052

JOB Old Portion of Pier Steved

SHEET NO. \_\_\_\_\_ OF \_\_\_\_\_

CALCULATED BY \_\_\_\_\_ DATE \_\_\_\_\_

CHECKED BY \_\_\_\_\_ DATE \_\_\_\_\_

SCALE \_\_\_\_\_

Bent 12 2" loss Around Perimeter of JACKET starts 2' Below CAP  
Pile 8 RUNS to midline

Bent 13 - 9 Piles total P1 - 4' Below CAP to mud 1" loss

Bent 14 Bent to Bent 6' apart 13-14

Bent 13-15 - low water whole Broken North side

Bent 15 TYPICAL 12"  $\phi$  Piles

Bent 16 P1 - 6"  $\phi$  Pile 1' Exposed Below JACKET

P2 - 6"  $\phi$  Pile timber

P9 - Jacket loss 2" Around Perimeter

P10 - Jacket 3" loss From CAP to BOTTOM  
Exposed ReBAR

Bent 17 Pile 1 8"  $\phi$  1' exposed  
timber



CHILDS ENGINEERING CORPORATION

Waterfront and Structural Engineering

BOX 333, MEDFIELD, MA 02052

JOB New Bedford

SHEET NO. 1 OF \_\_\_\_\_

CALCULATED BY RCF DATE 11/17/08

CHECKED BY \_\_\_\_\_ DATE \_\_\_\_\_

SCALE \_\_\_\_\_

Steamship Pier 01D

arrive on site 0730

set up, station bullheads

PPE, RTW Pweis in @ 950

PO# Bent 29

Pile 1 South Side Quad 3

cracking top down 3' CCS → CCS

Quad 2

Top 2' vert cr. Gran Cap  
 $\frac{1}{8}$ " wide

Pile cap in good condition

Pile 3 Quad 2 vert cr.  $3\frac{1}{2} \times \frac{1}{8}$ " w/ Rust stains

Pile 1 - 1' of timber exposed Piles 2 & 3 just concrete

Pile cap 1's of Pile 4 1" sp w/ Rust stain 1" deep

Pile 4 Quad 1 & 2 vert cr.  $2 \times \frac{1}{8}$ " mult cracks  
top down 2'

1' south of Pile 6 - Pile cap CCS bottom + outside face  $3\frac{1}{2} \times 2$ " deep  
w/ RB exposed

Pile 8 Quad 2-3 CCS  $3\frac{1}{2}$ " w/ Rust stains

Pile 9 MLW down 4' - exposed agg, concrete soft, 1-2  $\frac{1}{2}$ " deep

Quad 2 mult cr. CCS  $3\frac{1}{2}$ " w/ Rust stains @ top  
of pile 1' long



CHILDS ENGINEERING CORPORATION

Waterfront and Structural Engineering

BOX 333, MEDFIELD, MA 02052

JOB Steamship ~~OLD~~

SHEET NO. 2 OF \_\_\_\_\_

CALCULATED BY RGF DATE 11/27/08

CHECKED BY \_\_\_\_\_ DATE \_\_\_\_\_

SCALE \_\_\_\_\_

RTW  
Bent 28

Pile 1 top 2' of jacket  $\frac{1}{8}$ " cr, all around

Pile 1 + 2 1' of timber exposed  
12"  $\phi$  Pile 1  
10"  $\phi$  Pile 2

Pile 2 jacket sp 3" deep all around  
start 4' below cap to ML RB exposed

Pile 10 - 4' of exposed timber 14"  $\phi$  - pile head a good  
sp 4" deep w/ RB from 4' below  
Bent has no bracing to bottom of jacket 2' timber exposed  
Quod 2-3



CHILDS ENGINEERING CORPORATION

Waterfront and Structural Engineering

BOX 333, MEDFIELD, MA 02052

JOB Steamship 81D  
2

SHEET NO. \_\_\_\_\_ OF \_\_\_\_\_

CALCULATED BY \_\_\_\_\_ DATE \_\_\_\_\_

CHECKED BY \_\_\_\_\_ DATE \_\_\_\_\_

SCALE \_\_\_\_\_

Bent 27 RJW

File 9 4' of timber exposed 14"  $\phi$  good condition

No bracing on bent





CHILDS ENGINEERING CORPORATION

Waterfront and Structural Engineering

BOX 333, MEDFIELD, MA 02052

JOB Steamship Area Old

SHEET NO. \_\_\_\_\_ OF \_\_\_\_\_

CALCULATED BY \_\_\_\_\_ DATE \_\_\_\_\_

CHECKED BY \_\_\_\_\_ DATE \_\_\_\_\_

SCALE \_\_\_\_\_

Bent 30 PDI

Pile 10 bottom 6' RA exposed Quail 2, 3, 4

Quail 4 Vert Cr. 3'ls x 1/8" top down 3'

bent 27 10 piles rot 9

Bob

pile 1 bottom 1' of pile exposed 10" diameter  
marine bore damage

top 2' has 1/8" cracks around perimeter

bent 26 pile 1 identical to bent 27 pile 1

PDI

bent 30 pile 7 qu. 1 @ top 1/8" crack 3' long  
Bent 30 qu. 4/1 same crack

PDI

Bent 30  
pile 6 bottom 3' has hoop steel exposed at qu.

pile 5 qu. 1 whole quail CCS 3 sq. Ft. 2" deep

Bob

Bent 26  
bent 26 pile 10 conc. jacket loss of 4" around perimeter  
Starting 5' down from cap going 3'

bottom 2' of pile exposed

no bracing



CHILDS ENGINEERING CORPORATION

Waterfront and Structural Engineering

BOX 333, MEDFIELD, MA 02052

JOB Steamship 01D

SHEET NO. \_\_\_\_\_ OF \_\_\_\_\_

CALCULATED BY \_\_\_\_\_ DATE \_\_\_\_\_

CHECKED BY \_\_\_\_\_ DATE \_\_\_\_\_

SCALE \_\_\_\_\_

Bent 30

Pile 3 1" north OSC 1" deep w/ CB 1# on bottom  
of pile cap

Piles 1-8 cone packet goes into ML

Pile 1 Quad 1 vert cr @ cap down 3'  $\frac{1}{8}$ " wide

Quad 2 2 vert cr @ cap down 3'  $\frac{1}{8}$ " wide  
Under side of cap 1# CCS w/ Rust stains  
6" south of pile



CHILDS ENGINEERING CORPORATION

Waterfront and Structural Engineering

BOX 333, MEDFIELD, MA 02052

JOB Steamship Old

SHEET NO. \_\_\_\_\_ OF \_\_\_\_\_

CALCULATED BY \_\_\_\_\_ DATE \_\_\_\_\_

CHECKED BY \_\_\_\_\_ DATE \_\_\_\_\_

SCALE \_\_\_\_\_

Bent 25 RTW - No bracing

Pile 10 - 2' of timber pile exposed 14"φ good cond.

Pile 1 - timber exposed 1' MB 12"φ remaining timber good  
damage

~~Bent 24~~

Bent 24 - bent has bracing

Pile 1 1' exposed timber 12"φ good

No bracing on bents from PDJ

Pile 9 - timber pile exposed 1' 1/2 14"φ good

Pile 10 - 5 <sup>timber</sup> pile exposed 14"φ good cond.

Bent 23 - bracing on bent

Piles 8, 9 same as 9 & 10 on Bent 24

Pile 2 Timber pile exposed 1' w/ MB 10"φ

Pile 1 " " " 3' w/ MB 12"φ to batter  
conc jacket 3" sp ~~sp~~ steel 3'  
below cap w/ RB exposed



CHILDS ENGINEERING CORPORATION

Waterfront and Structural Engineering

BOX 333, MEDFIELD, MA 02052

JOB Stennis Ship 010

SHEET NO. \_\_\_\_\_ OF \_\_\_\_\_

CALCULATED BY \_\_\_\_\_ DATE \_\_\_\_\_

CHECKED BY \_\_\_\_\_ DATE \_\_\_\_\_

SCALE \_\_\_\_\_

Bent 31 PDI No bracing

Pile 2 - Horiz on Quad 1 Map cracking 4# w rust @ top of pile

Pile 4 Quad 1 OCS 3# top of pile 2" deep

1' south of Pile 5 OCS 1# x 1/2" deep bottom of cap

Pile 6 Quad 4 3' below cap 6" ~~spalled~~ <sup>spalled</sup> w/ RB exposed

Pile 7 + 8, 9 sp all Quad 1" deep exposed agg  
bottom 3' of jacket

No timber pile exposed

Pile 10 - timber pile exposed 4' MB 1/8" deep max  
12"  $\phi$  good cond.

Bent 32 PDI

Pile 10 timber exposed 4' 14"  $\phi$  good

Pile 9 " " 2' 14"  $\phi$  MB w/ 1/4" loss

Pile 8 bottom 4' of conc jacket sp 2 1/2" deep w/ RB all quad.

Pile 6 Quad 2, 3, 4 bottom 4 1/2' RB exposed 2" loss of conc.

Pile 5-6 underside of cap 1# sp x 1/2" deep OCS


Pile 5 Quad 1, 2, 4 sp loss 1" deep bottom 3'

Pile 4 all Quad sp 1" deep bottom 3'

Pile 2 conc jacket bottom 3' sp 1" deep all quad.

1' timber pile exposed

Pile 1 ~~1'~~ 1' of timber exposed 12"  $\phi$  1/4" deep MB

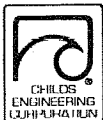

CHILDS ENGINEERING CORPORATION

Waterfront and Structural Engineering

BOX 333, MEDFIELD, MA 02052

JOB Steamship Sid

SHEET NO. \_\_\_\_\_ OF \_\_\_\_\_

CALCULATED BY \_\_\_\_\_ DATE \_\_\_\_\_

CHECKED BY \_\_\_\_\_ DATE \_\_\_\_\_

SCALE \_\_\_\_\_

Bent 22 RJW - bracing present

Pile 1 3' timber exposed 13"φ MB - 1" trenches - good

Pile 9 3' " " > 14"φ good cond.

Pile 10 4' " " "

Bent 21 Pile 10 4' timber exposed 12"φ MB minor  
Has bracing 9 2' " " 14"φ good  
No cap rag

Pile 1 18" timber pile exposed 9"φ MB 2" loss

Bent 20 RJW - bracing present on pile 1-2 connected, mat connected on piles 3,4,5

Pile 1 - 18" timber exposed 7"φ by MB

Pile 8 - 12" timber exposed 12"φ good

9 3' " " 14"φ good

10 4' " " 13"φ good

Bent 19

Pile 10 4' timber pile exposed 13"φ good cond

Pile 9 2' " " 13"φ good cond

Bent 18 - 20 low walk on fender missing

Pile 8 6" pile exposed 12"φ good cond

Pile 2 6" " " 8"φ Heavy MB 4" loss

Pile 1 2' " " 14"φ light MB





CHILDS ENGINEERING CORPORATION

Waterfront and Structural Engineering

BOX 333, MEDFIELD, MA 02052

JOB STEAMSHIP OIL

SHEET NO. \_\_\_\_\_ OF \_\_\_\_\_

CALCULATED BY \_\_\_\_\_ DATE \_\_\_\_\_

CHECKED BY \_\_\_\_\_ DATE \_\_\_\_\_

SCALE \_\_\_\_\_

### Bent 33 POI

Pile 2 Quad 3, 4, 1 exposed RB Sp 2-2 1/2" deep  
bottom 4' of jacket  
2 vert cr. x 2 1/8 x 1/8" on Quad 3 @ top down

Pile 6 Sp bottom 3' all quad 1" deep

Pile 7 bottom 6" Sp RB exposed 2" deep all quad.  
Quad 2, 2-vert cr. from cap down 2' 1/8" w/ Rust stains

Pile 10 Sp on jacket 1 1/2" deep w/ RB starts 4' below cap  
5' long all quad

\* w/w Photo - exposed timber 4' MB 1 1/2"-2" deep pocket  
6" φ

Bents 33 & 34 ~~South~~ North side Conduits into water, broken  
w/ cable exposed - at wharf structure

Photo 80-89 Pile 10 Bent 33 - marine base

Pile 10 Bent 34 bottom 4' of pile exposed  
3' below cap exp aggregate 1"-3" deep  
5' long section

Pile 9 bottom 2' of pile exposed - 12" φ

Pile 8 qu. 3, 1, 1 exposed bar - conc. loss 1" deep  
starts 4' below cap, 5' long

Pile 7-6 exp. agg. loss all quad. Typ. 1" deep  
4' vertical section

Pile 4 bottom 1' of pile exp.  
marine base 1" deep, pile 10" φ



CHILDS ENGINEERING CORPORATION

Waterfront and Structural Engineering

BOX 333, MEDFIELD, MA 02052

JOB \_\_\_\_\_

SHEET NO. \_\_\_\_\_ OF \_\_\_\_\_

CALCULATED BY \_\_\_\_\_ DATE \_\_\_\_\_

CHECKED BY \_\_\_\_\_ DATE \_\_\_\_\_

SCALE \_\_\_\_\_

Bent 10 RJW

Pile 1 x 9 1' timber exposed 12" good  
Pile 10 4' timber exposed minor MB 14" φ good

5 piles total 10" diam  
everything looks new

Piles 2 + 4 notched 4" deep for bracing

seawall at back of pier conc. to midline  
each cap  
last pile 5' away from seawall

STEAMSHIP  
PIER DTD



Bent 2 has 3 piles

COAL Pocket  
BOARDWALK

Bent 5 pile 3 <sup>low water</sup> crossbrace connection bad, 3' at base 80% deteriorated

Bent 6 pile 3 low water crossbrace same ↑ as bent 5

Stone seawall seeps 6" to 1" voids behind 3' irregular stone set  
Void in wall 6' below top @ Sta 3+40  
1'4" x 3'w x 7' deep

- 4'x4'x2'h in seawall @ corner Sta 3+87

timber fender piles - long MB x 8" φ remaining @ MR  
all piles along face





CHILDS ENGINEERING CORPORATION

Waterfront and Structural Engineering

BOX 333, MEDFIELD, MA 02052

JOB Steamship Pier Old

SHEET NO. \_\_\_\_\_ OF \_\_\_\_\_

CALCULATED BY \_\_\_\_\_ DATE \_\_\_\_\_

CHECKED BY \_\_\_\_\_ DATE \_\_\_\_\_

SCALE \_\_\_\_\_

Bent 34 PDI

Pile 2 ex. agg. TYP. 1" deep loss section 3' long

Pile 3 heavy MB 3/4" deep 1' on bottom pile exposed effective area about 6"

Pile 1 bottom 2' of pile exposed light MB 1/4 - 1/8" effective diam 12"

Bent 35

Pile cap - right above pile 2 vert. cracks 2' long 1/8" wide

~~Bent~~

Drystack granite seaward inshore of Bent 36 about 4 courses high about 7' inshore of Bent 36

Bent 35

Pile 5 CCS @ 2/3 1" deep 3 sq. feet w/ rust stains 4' below cap exposed bar typ. loss 1" running 4'

6 top of pile cap crushing crack running down 3' in Q3 1/8" wide distance 4' all rebar exposed typ loss of concrete 3-3 1/2" all of quad. 3 turning into CCS

Bent 36

Pile 516 expose RB 4' below pile cap 3' long typ. loss 2-2 1/2"



CHILDS ENGINEERING CORPORATION

Waterfront and Structural Engineering

BOX 333, MEDFIELD, MA 02052

JOB \_\_\_\_\_

SHEET NO. \_\_\_\_\_ OF \_\_\_\_\_

CALCULATED BY \_\_\_\_\_ DATE \_\_\_\_\_

CHECKED BY \_\_\_\_\_ DATE \_\_\_\_\_

SCALE \_\_\_\_\_

Bent 34 PDI

Pile 5 @ 1 CCS 2 sq. Ft. 1" deep

Between <sup>PILES</sup> 4-7 each section between piles all 3 faces  
cracks 1/16" w/ leeching

STEAMSHIP  
CID

Bent 35

Pile 8 exposed RB 1' from top of pile going S'  
typ. loss 4" deep

Steel bulkhead at N side of pier - runs perpendicular to pier w/ wale  
supporting pier

3 piles running  $\perp$  to bulkhead  
1st pile 12' from bulkhead cap sits on wale

STEAMSHIP  
BOARDWALK

Bent 17

Sta. 182.7 - D meter

Mudline outside F 420"  
web 480.280" .319 pat. reading  
inside F 415"

Typ. steel uncoated pits starting 1/8" deep max 1/4" wide

Midway outside F 285 at top 525 out of  
web 205 1306 pat. reading 355 web  
inside F 420 .520 inside F  
Steel smooth, 80% coating intact

Typ. steel 1/4" black byproduct pits 1/4" deep 1/2" wide

Ext. trans wale - w/ 2" dia rod w/ ±10' spacing Sta 1+82  
2 tie rods



CHILDS ENGINEERING CORPORATION

Waterfront and Structural Engineering

BOX 333, MEDFIELD, MA 02052

JOB \_\_\_\_\_

SHEET NO. \_\_\_\_\_ OF \_\_\_\_\_

CALCULATED BY \_\_\_\_\_ DATE \_\_\_\_\_

CHECKED BY \_\_\_\_\_ DATE \_\_\_\_\_

SCALE STEAMSHIP BOARDWALK

1<sup>st</sup> timber piles, outside of bulkhead 10' Bent 18  
timber pile cap sits on bulkhead wale

~~outside~~ 3' of pile cap bent 2 is cracked, rattled,  
pile back 1' from end

12, 14, 15

Bent ~~4, 5~~ Same as Bent 2 on pile cap condition

low water balts X bracing piles 2-3 + 1-2 + long X bracing  
along pile 1, bent to bent

balts @ low water 50% corroded

BENT 15

D meter @ ~~bent 4~~ Sta 0+68


out fl .520" } at ML steel 80% coated  
web .375 } smooth - good  
inside fl .500 }

at fl .515" } @ mid steel smooth  
web .365 } 1-pit 1/8" deep x 1/16"  
inside fl .505 } coating 50% intact

out fl .515" } @ top 80% intact coating  
web .370" } small pitting  
inside fl .510" } 2" p holes sheet - similar to earlier  
steel bulkhead  
fill visible

Timber piles + bracing top in good condition  
low balts



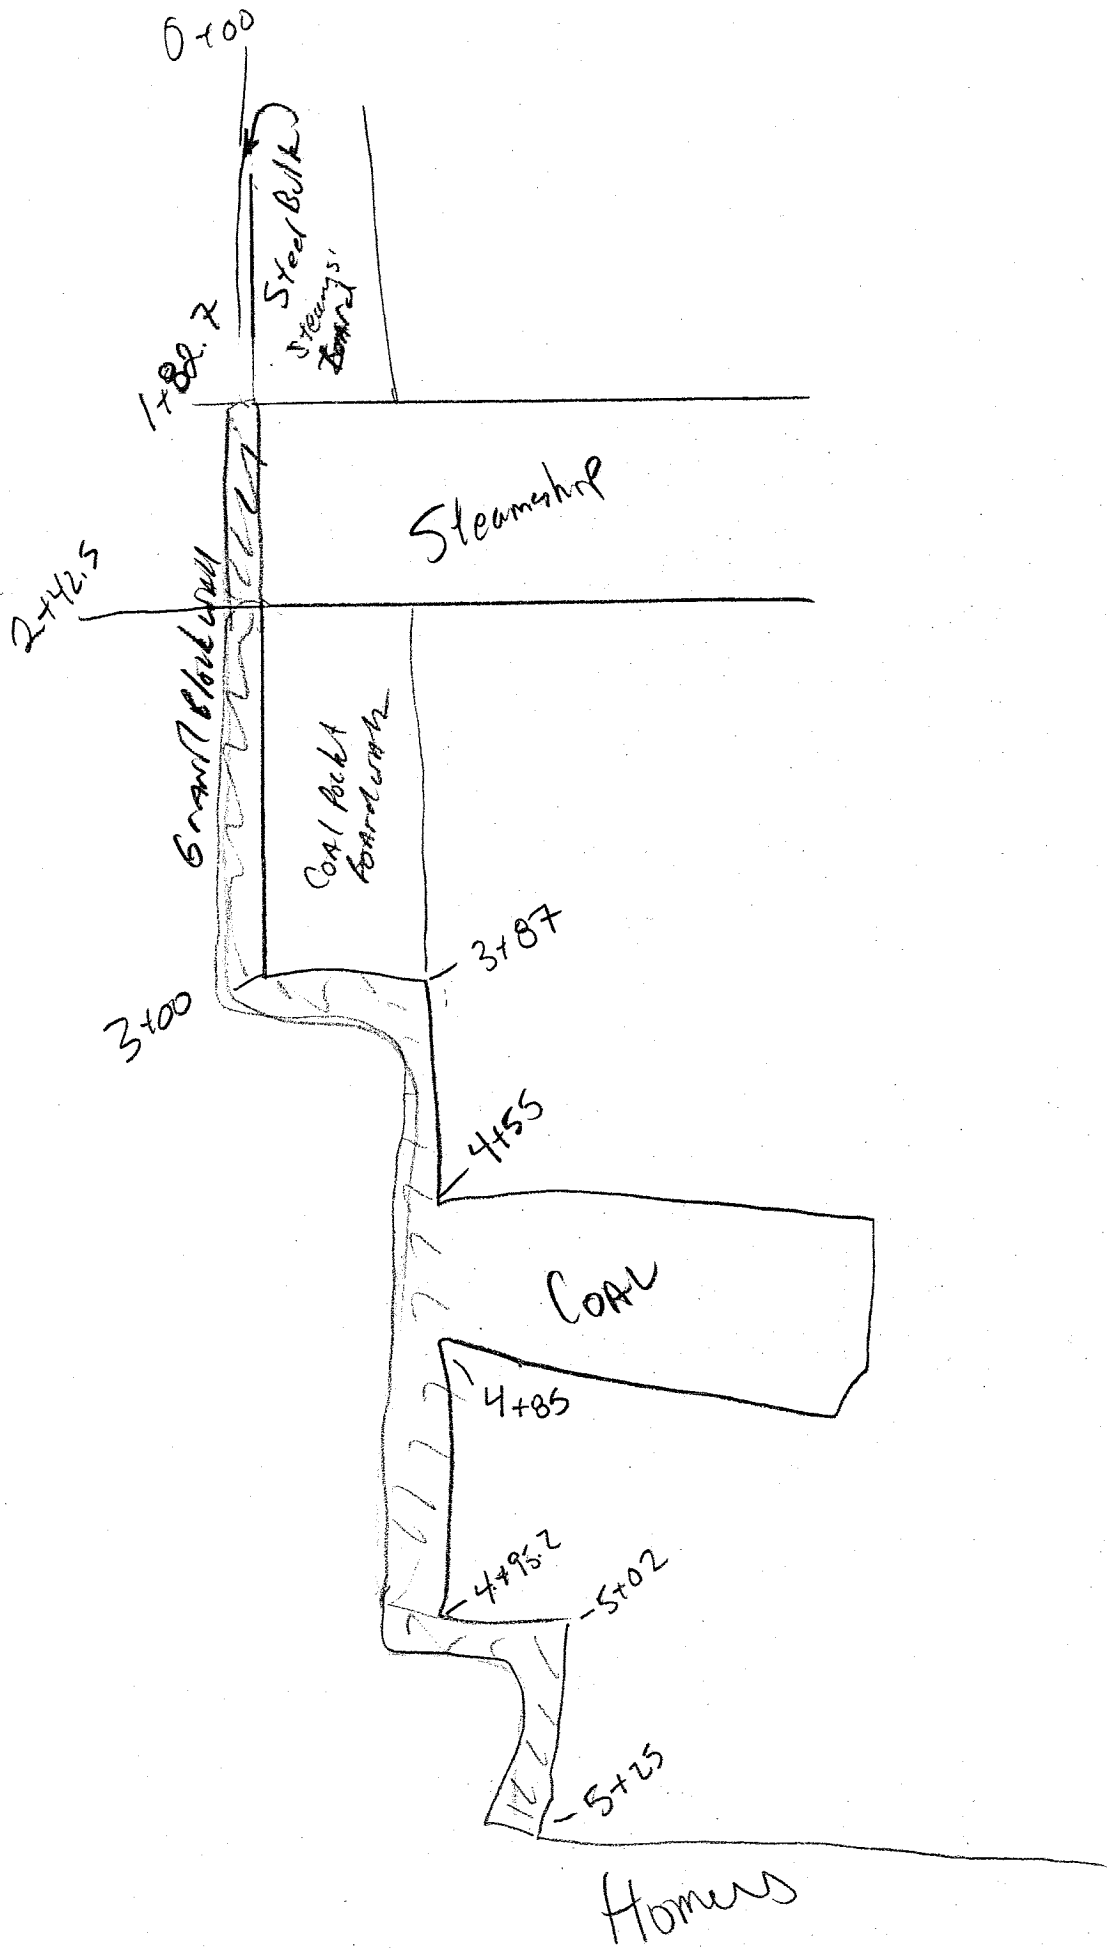



CHILDS ENGINEERING CORPORATION

Waterfront and Structural Engineering

BOX 333, MEDFIELD, MA 02052

JOB \_\_\_\_\_

SHEET NO. \_\_\_\_\_ OF \_\_\_\_\_

CALCULATED BY \_\_\_\_\_ DATE \_\_\_\_\_

CHECKED BY \_\_\_\_\_ DATE \_\_\_\_\_

SCALE \_\_\_\_\_

BENT 12

After bent 7 12'x12' on top of sheet pile supporting  
stringers

~~Bent 7~~ pile cap ratted & split outside 4' of 12'x12'  
on sheet pile

D-meter @ bulkhead corner Sta 0+00 6' of water

out fl	305"	} ML	1/4" corrosion by product coating missing different sheet section 304 pot. reading old steel - coating 30% intact at top
web	245"		
inside fl	225"*		
out fl	325	} +OP	303 pot. reading
web	335		
inside fl	330		

OUTFALL SECTIONS are 6' O.C.

Stents @ 6' o.c.  
Over

Outfall @ bent 10-11 \* Bent # OK From here ON ↓ \*

Pile cap Bent 9 - outside 2' ratted & split  
diag bracing not connected @ pile 3, bracing 2-3

Pile cap sits on bulkhead wall on inshore end

Bent 8 Pile 3 - abraded 30% from pile cap down 5'  
↑ outside pile from floating dock

Bents 10-9, 9-8 & 8-7 no outside diag bracing on outside pile

Bent 7 diag. bracing from outside to mid pile - missing

Pile 3 light MB @ ML 14" φ  
↑ +OP





CHILDS ENGINEERING CORPORATION

Waterfront and Structural Engineering

BOX 333, MEDFIELD, MA 02052


JOB \_\_\_\_\_

SHEET NO. \_\_\_\_\_ OF \_\_\_\_\_

CALCULATED BY \_\_\_\_\_ DATE \_\_\_\_\_

CHECKED BY \_\_\_\_\_ DATE \_\_\_\_\_

SCALE \_\_\_\_\_

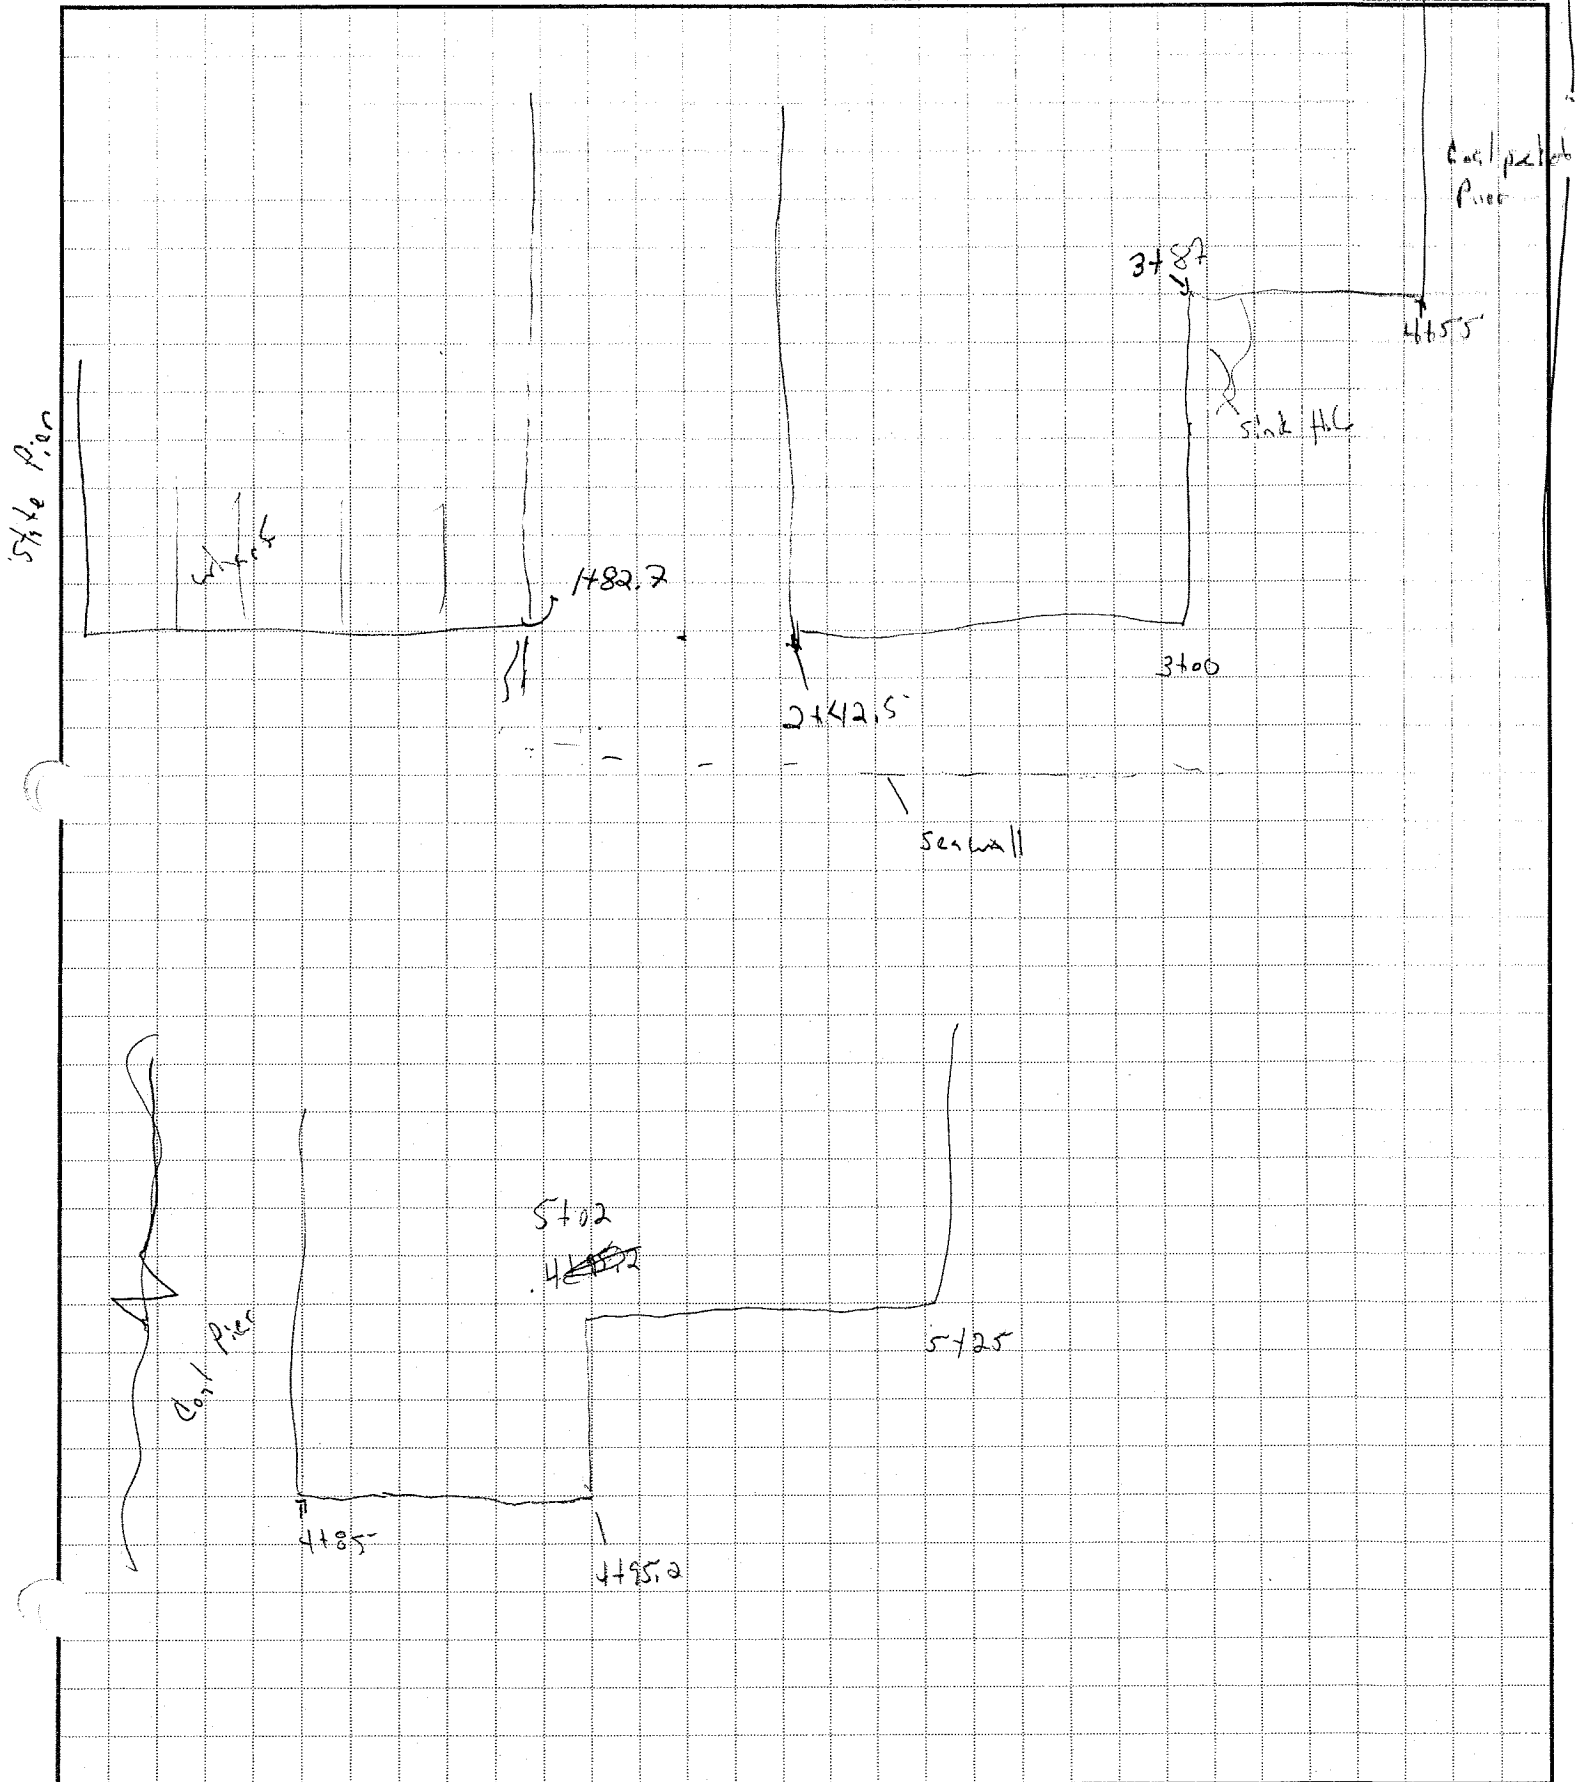



CHILDS ENGINEERING CORPORATION

Waterfront and Structural Engineering

BOX 333, MEDFIELD, MA 02052

JOB \_\_\_\_\_

SHEET NO. \_\_\_\_\_ OF \_\_\_\_\_

CALCULATED BY \_\_\_\_\_ DATE \_\_\_\_\_

CHECKED BY \_\_\_\_\_ DATE \_\_\_\_\_

SCALE \_\_\_\_\_

Bent 6 - pile cap rotted & crushed outside 4'  
not supported by pile

bracing bolts 50% corroded at low connections

Bent 4 pile cap rotted 4' outside end, 25% section remains

X-bracing from Bents 5 to 4 & 4 to 3 ~~by~~ 1 piece missing on each

Bent 3 outside 4' of pile cap rotted, 25% remaining  
Pile 3 driven at an angle

Bent 2 Pile cap outside 12" rotted - extends beyond wharf face

Bent 1 same as Bent 2

Dues out 13/5