

CONTRACT DRAWINGS

- FOR -

CONTRACT NO. 04-01

SEWER SYSTEM EXPANSION

MARION, MASSACHUSETTS

MARCH 2004

(REVISED NOVEMBER 2004 AND APRIL 2005)
REVISED TO RECORD PLANS DECEMBER 2006


INDEX

LEGEND

PL	- PROPERTY LINE	○	- TREE
PP	- POWER POLE (PP)	WG	- WATER SERVICE
B-1	- SOIL BORING	HYD	- EXISTING FIRE HYDRANT
P-1	- SOIL PROBE	WG	- WATER GATE
BORING NO.1 OR PROBE NO. 1 REFER TO SECTION 01310 FOR DETAILED BORING LOG		100'	- 100' BUFFER ZONE
---	- EXISTING WATER	L	- LIMIT-OF-WORK
---	- EXISTING GAS	---	- NEW LOW PRESSURE SEWER
---	- EXISTING DRAIN	---	- NEW 1 1/4" LOW PRESSURE SERVICE CONNECTION
DMH	- EXISTING DRAIN MANHOLE	---	- NEW 6" GRAVITY SERVICE CONNECTIONS
CB	- EXISTING CATCH BASIN	○	- NEW PREFABRICATED LOW PRESSURE PUMP
SMH	- EXISTING SEWER MANHOLE	---	- ATLANTIC SHORELINE
ABANDONED ONSITE DISPOSAL SYSTEM			
---	- EXISTING CONTOUR		
X 23.30	- EXISTING SPOT ELEVATION		

GENERAL NOTES

- LOCATIONS OF ALL UTILITIES AND SUB-SURFACE STRUCTURES ARE FROM SURVEY AND RECORDS OF THE TOWN, CORPORATIONS, ETC., AND ARE CONSIDERED APPROXIMATE BOTH AS TO SIZE AND LOCATION AND ARE INDICATED ON THESE DRAWINGS TO GIVE BIDDERS A GENERAL IDEA OF EXISTING CONDITIONS TO BE INVESTIGATED BY THE BIDDER. IT IS UNDERSTOOD AND AGREED THAT EACH BIDDER WILL NOT RELY UPON THESE DRAWINGS FOR SUCH INFORMATION, BUT THAT EACH BIDDER SHALL MAKE EXAMINATIONS IN THE FIELD BY VARIOUS AVAILABLE METHODS AND SHALL OBTAIN INFORMATION FROM UTILITY CORPORATIONS AND INDIVIDUALS AS TO THE LOCATION OF ALL SUB-SURFACE STRUCTURES.
- ALL ELEVATIONS REFER THE NAD83 HORIZONTAL DATUM.
- BASE SURVEY PERFORMED BY JAMES W. SEWELL COMPANY, OLD TOWN, MAINE AND HERITAGE DESIGN GROUP, UXBRIDGE, MASSACHUSETTS.
- LOCATION OF PROPERTY LINES ARE FROM ASSESSORS MAPS AND ARE APPROXIMATE.
- WETLAND AREAS DELINEATED BY EARTH TECH JUNE 2003.
- SUBSURFACE EXPLORATION PERFORMED BY EARTH EXPLORATION CORP., WRENTHAM, MASSACHUSETTS SEPTEMBER, 2003.
- THE WORK FOR THIS PROJECT IS IN CLOSE PROXIMITY TO EXISTING UTILITIES.
- SEWER SERVICES INCLUDE 6" PVC GRAVITY SEWER SERVICE CONNECTION, 1 1/4" PVC LOW PRESSURE SEWER SERVICE CONNECTION ON PRIVATE PROPERTY, 1 1/4" PVC LOW PRESSURE SEWER SERVICE CONNECTION FROM MAIN LINE TO PROPERTY LINE, INSTALLATION OF LOW PRESSURE SEWER PREFABRICATED GRINDER PUMP UNIT, AND ABANDONMENT OF EXISTING ON-SITE SYSTEM.

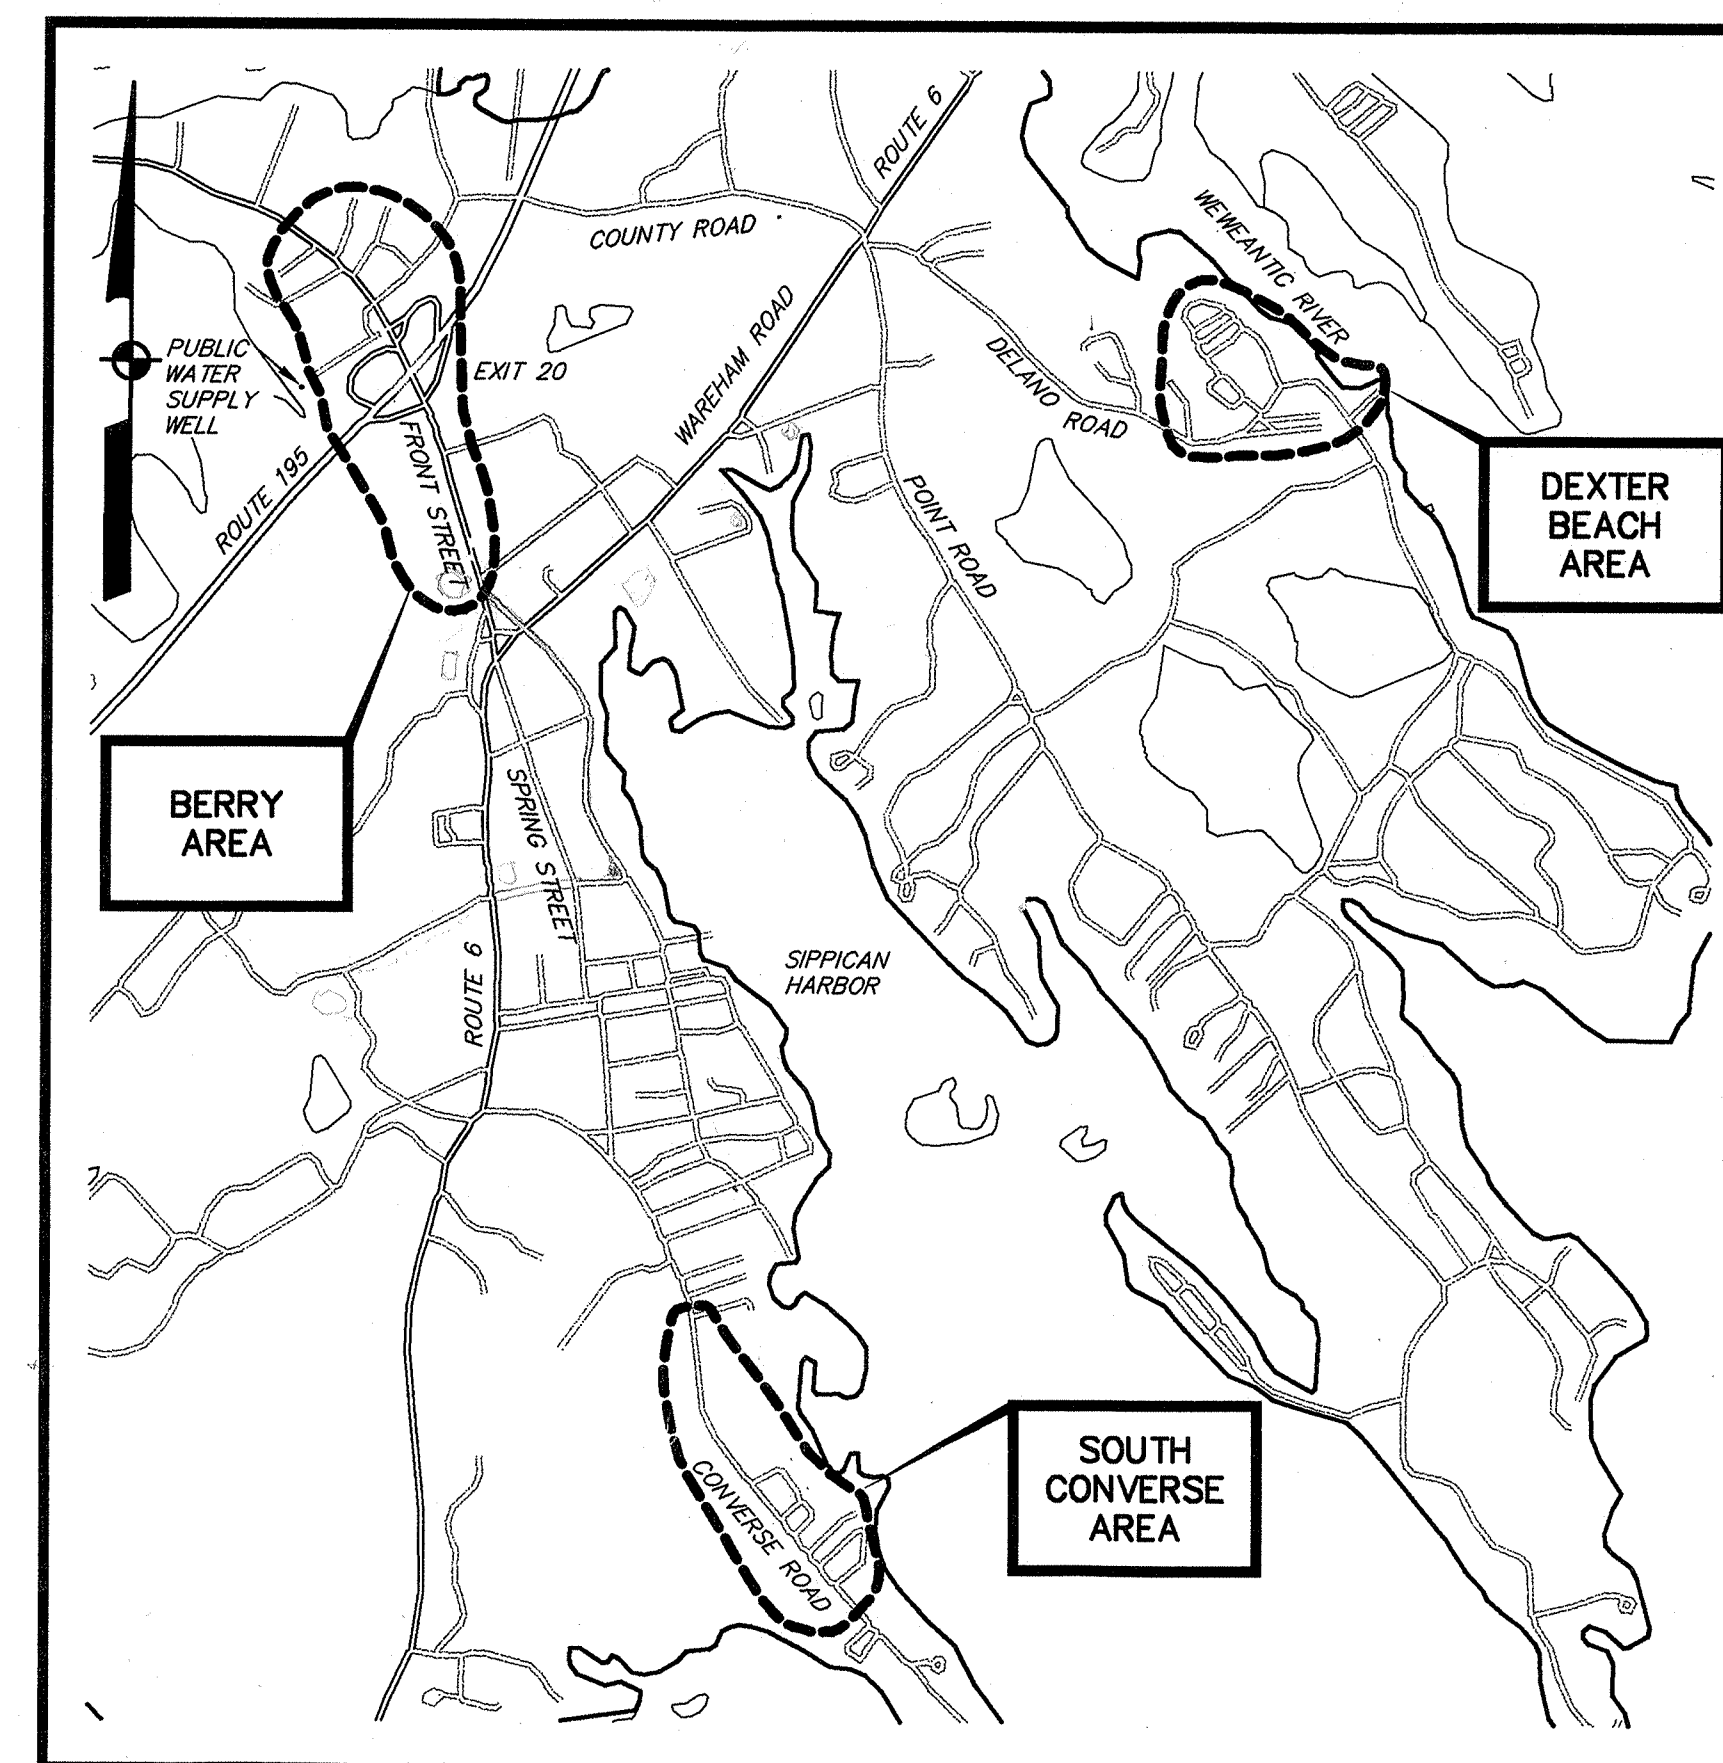

LOCUS
NOT TO SCALE




300 Baker Avenue, Suite 290, Concord, Mass.

TITLE

SHEET NO.

COVER	1
BERRY AREA	2
FRONT STREET	
BERRY AREA	3
FRONT STREET/ HUCKLEBERRY WAY	
BERRY AREA	4
COUNTY/ BLUEBERRY/ CRANBERRY/ BOXBERRY	
BERRY AREA	5
PUMPING STATION ROAD	
BERRY AREA	6
FRONT ST/ BRIGGS TER/ INLAND RD	
DEXTER BEACH AREA	7
DELANO ROAD	
DEXTER BEACH AREA	8
DELANO/ PIERCE/ OAK/ MANSFIELD	
DEXTER BEACH AREA	9
DELANO ROAD/ BASS POINT ROAD	
DEXTER BEACH AREA	10
DEXTER ROAD/ DORAN WAY/ SHADY LANE	
DEXTER BEACH AREA	11
DEXTER/SEAHORSE/WILSON/COLE/HIRAM/JULIAN	
SOUTH CONVERSE AREA	12
CONVERSE ROAD	
SOUTH CONVERSE AREA	13
CONVERSE/ CARD/ RESERVATION/ ARROWHEAD	
SOUTH CONVERSE AREA	14
JOBS COVE ROAD TO QUELLE LANE	
SOUTH CONVERSE AREA	15
BAYBERRY LANE TO HARTLEY LANE	
SOUTH CONVERSE AREA	16
HARTLEY LANE TO END	
BERRY AREA	17
ROUTE 105 BRIDGE CROSSING DETAILS	

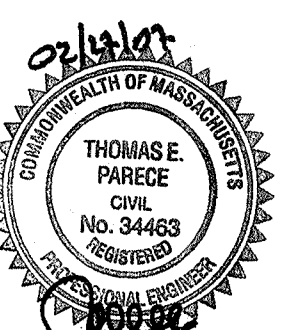

RECORD PLAN

CWSRF 1725

SHEET 1 OF 17