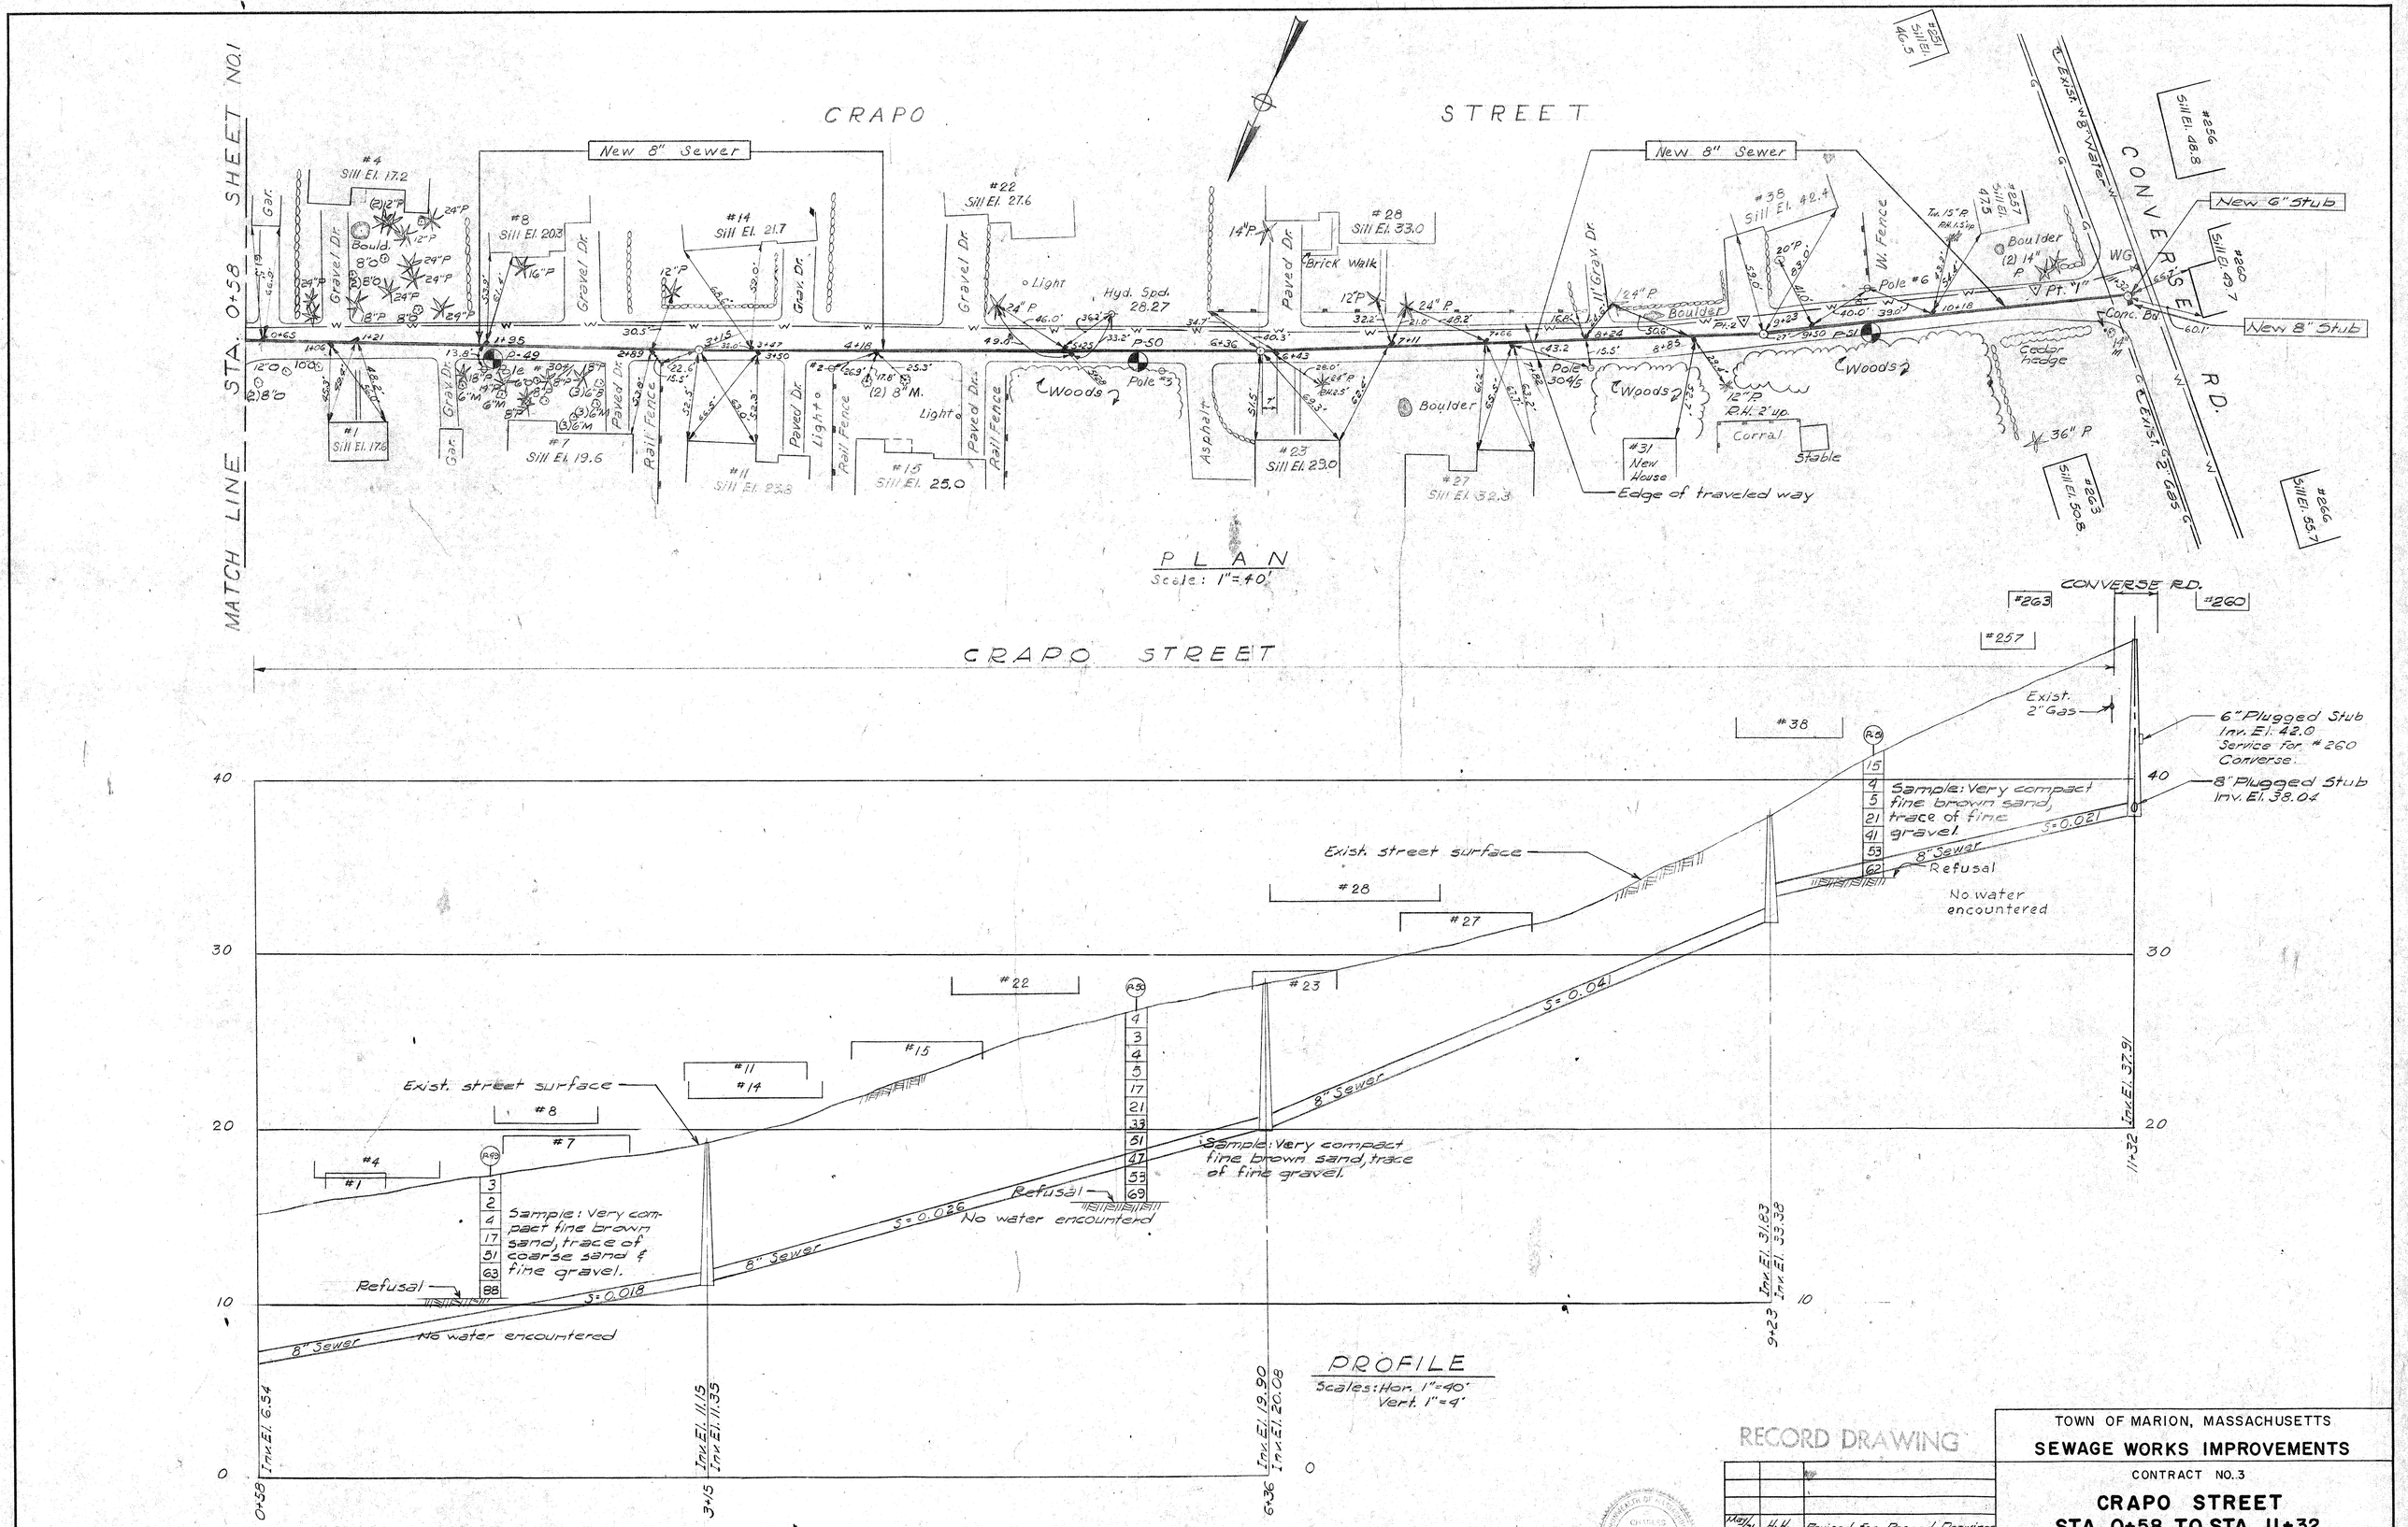

RECORD DRAWING

Date	Ch'k'd.	Revision
May/71	H.H.	Revised for Record Drawings

Drawn by: A.R.R.
Checked by: M.A.D.
Approved by: C.A.P.
Date: August, 1969.
Scale: As Noted

TOWN OF MARION, MASSACHUSETTS

SEWAGE WORKS IMPROVEMENTS

CONTRACT NO. 3

CRAPO STREET
STA. 0+58 TO STA. 11+32

CAMP, DRESSER & McKEE
Consulting Engineers
Boston, Mass.

SHEET NO. 3

357-10804

ANDREW T. JOHNSON CO., INC. 3579