RECORD PLAN AND PROFILE

MATTAPOISETT ROAD

MARION

LAID OUT AS A STATE HIGHWAY MAY 2, 1901.
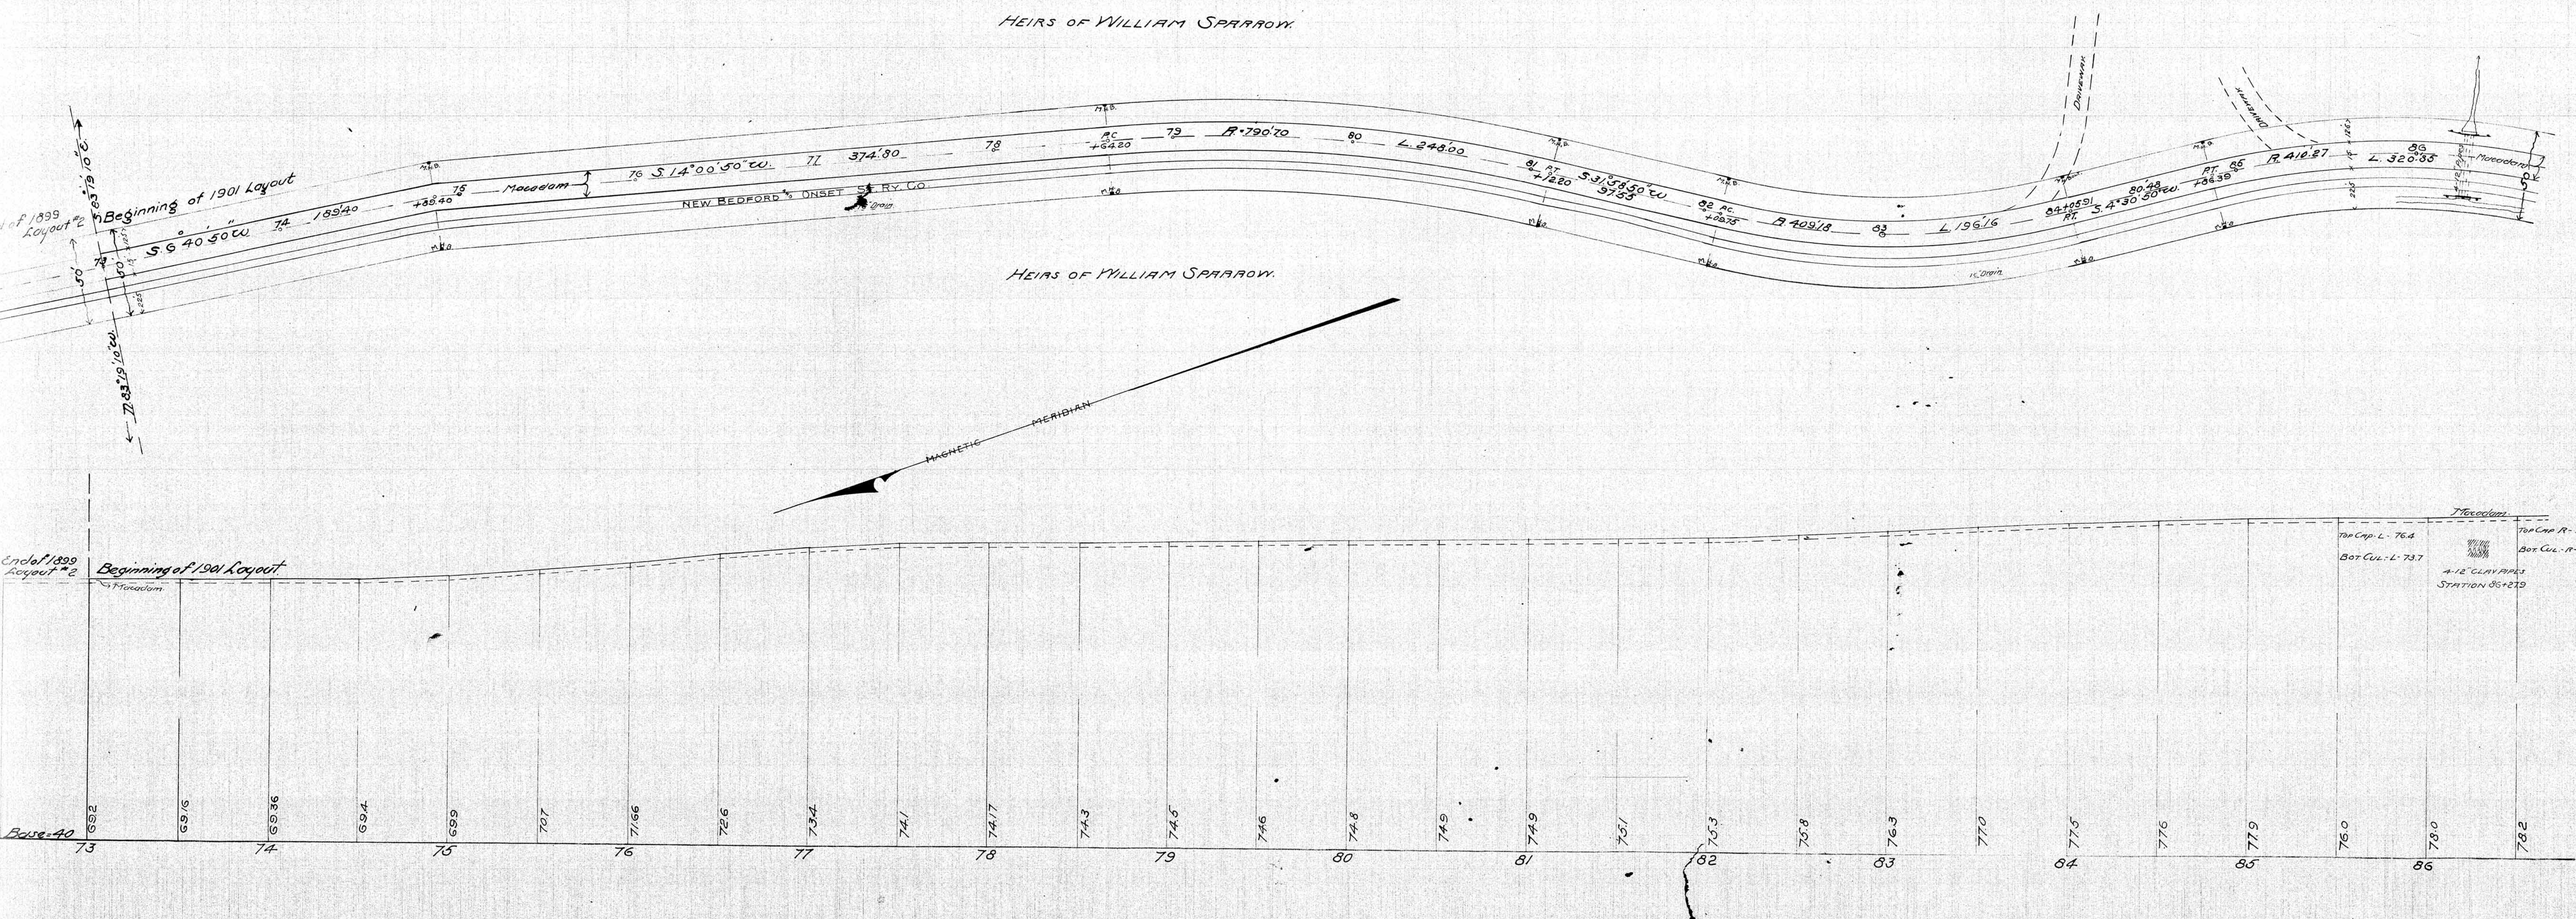
SCALES: PLAN: 1 IN.=40 FT. PROFILE: HOR. 1 IN.=40 FT. VERT 1 IN.=8 FT