PLAT #9, LOT #18
N/F
RIVER EDGE COMMON LAND TRUST

PLAT #10, LOT #1
#1019 POINT ROAD
N/F
FAUSTINO & MARY LOPES

PLAT #10, LOT #2
#1017 POINT ROAD
N/F
~~ESTATE OF LEOPOLDINA T. PINA~~
A.

PLAT #10, LOT #5
#1011C POINT ROAD
N/F
ELVIRA S. BARROS

PLAT #10, LOT #4
#1013 POINT ROAD
N/F
ESTATE OF JOHN DEPINA RIBEIRO

PLAT #10, LOT #8
N/F
~~ESTATE OF MANUEL PINA, II~~
D. Pina

PLAT #10, LOT #9
#1009 POINT ROAD
N/F
FAUSTINO A. LOPES ET AL

PLAT #10, LOT #10
#1007 POINT ROAD
N/F
~~ESTATE OF HAZEL G. LOPES~~
K. Fernandes

PLAT #10, LOT #11A
#1003 POINT ROAD
N/F
ANN K. PINA, JAMES C. DEPINA

PLAT #10, LOT #11B
#1001 POINT ROAD
N/F
~~ARLENE D. PINA~~
Lorraine Pina

P.L.

LINE

PAVED DRIVE

GRAVEL DRIVE

U.P. #23/64

SIGN

U.P. #23/65

18" CHERRY

10" MAPLE

"TO BE REPLACED"
CATCH BASIN
STA. 38+36 (17Rt.)
RIM EL.=15.64
12" INV.=12.72

HYDRANT

DWELLING

PAVED DRIVE

DWELLING

U.P. #23/66

14" CEDAR

PAVED DRIVE

EXISTING CONCRETE CURBING

U.P. #67

PAVED DRIVE

EDGE OF EXISTING PAVEMENT

SEWER MANHOLE
STA. 34+92(0.7Rt.)
RIM EL.=19.38

U.P. #68

PAVED DRIVE

LINE

PAVED DRIVE

12" CONC. PIPE

℄ CONSTRUCTION

10+0 39+0 38+0 37+0 36+0 35+0 34+0

24'

12'

12'

ANGLE PT. AT
STA. 35+46

MAILBOX

ROW OF MAILBOXES

TREELINE

MATCH LINE

CATCH BASIN
STA. 38+51 (15'Lt.)
RIM EL.=15.56
INV. UNKNOWN

SEWER MANHOLE
STA. 38+06(4'Lt.)
RIM EL.=16.10

PROPOSED
CATCH BASIN (11' Rt.)
STA. 38+38±
RIM EL.=15.77
INV.=12.69

STONE DRIVE

ROW OF MAILBOXES

W.S.

GRAVEL DRIVE

DWELLING

MAILBOXES

SEWER MANHOLE
STA. 35+87(0.2'Rt.)
RIM EL.=18.68

EXISTING CONCRETE CURBING

STONE DRIVE

MAILBOX

ROW OF ARBORVITES

W.G.

14" SPRUCE

STONE DRIVE

MATCH LINE

BARROS DRIVE

PLAT #11, LOT #~~128~~ 129
N/F
~~CARL GOMES~~
Ed. Correia
1022 Point Rd.

PLAT #11, LOT #~~129~~ 128
N/F
CARL CHRIS GOMES

PLAT #11, LOT #95
#1018 POINT ROAD
N/F
CARL C. GOMES

PLAT #11, LOT #96
N/F
CARL GOMES

PLAT #11, LOT #97
#1010 POINT ROAD
N/F
CARL GOMES

PLAT #11, LOT #100
#1008 POINT ROAD
N/F
JULIO PINA

PLAT #11, LOT #99A
N/F
ANTONE & MARY MELLO

PLAT #11, LOT #101
#1006 POINT ROAD
N/F
ESTATE OF JOSEPH JOSEPH

N

PLAN VIEW
SCALE: 1"=20'

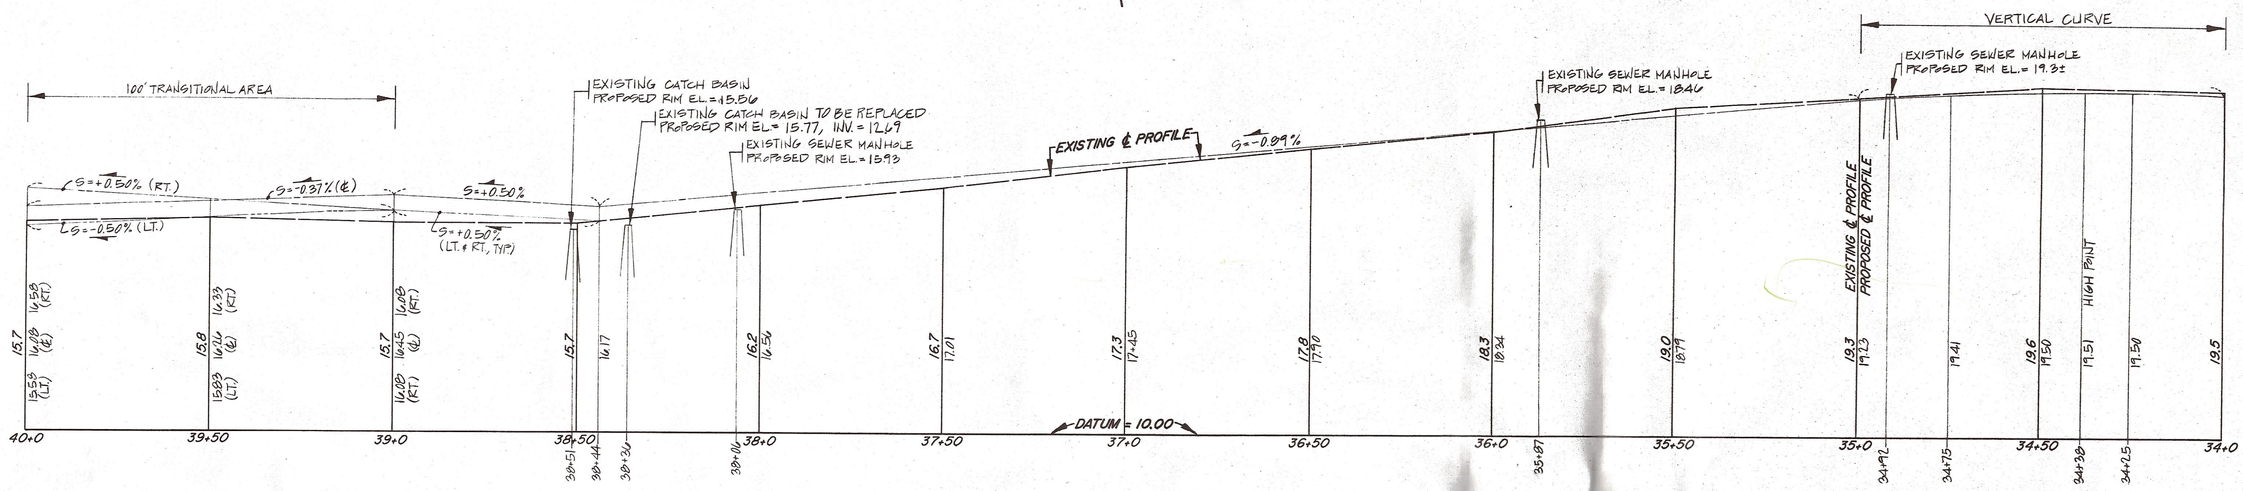

PROFILE VIEW
SCALE: VERTICAL: 1"=2'
HORIZONTAL: 1"=20'

Plan of Roadway Enhancements for Point Road
from
Bullivant Farm Road
to
Wareham Street (Route 6)

September 16, 2004
Prepared by the Marion Circulation Committee.

SHEET 3 OF 4 SHEETS

COMMONWEALTH OF MASSACHUSETTS
ARTHUR C THOMPSON
No. 8893
REGISTERED PROFESSIONAL ENGINEER

PLAN AND PROFILE
OF
POINT ROAD
IN
MARION, MA.
FEBRUARY 28, 1994 SCALE AS NOTED
THOMPSON SURVEYING & ENGINEERING, INC.
525 MILL STREET
MARION, MA.

NO.	REVISION DATE	DESCRIPTION

Trees as Space Permits

Sheet 3 of 4